


TOTAL SF AVAILABLE - 2,177 RSF (12.6%)

[Click to access CADD file](#)

Key Plan

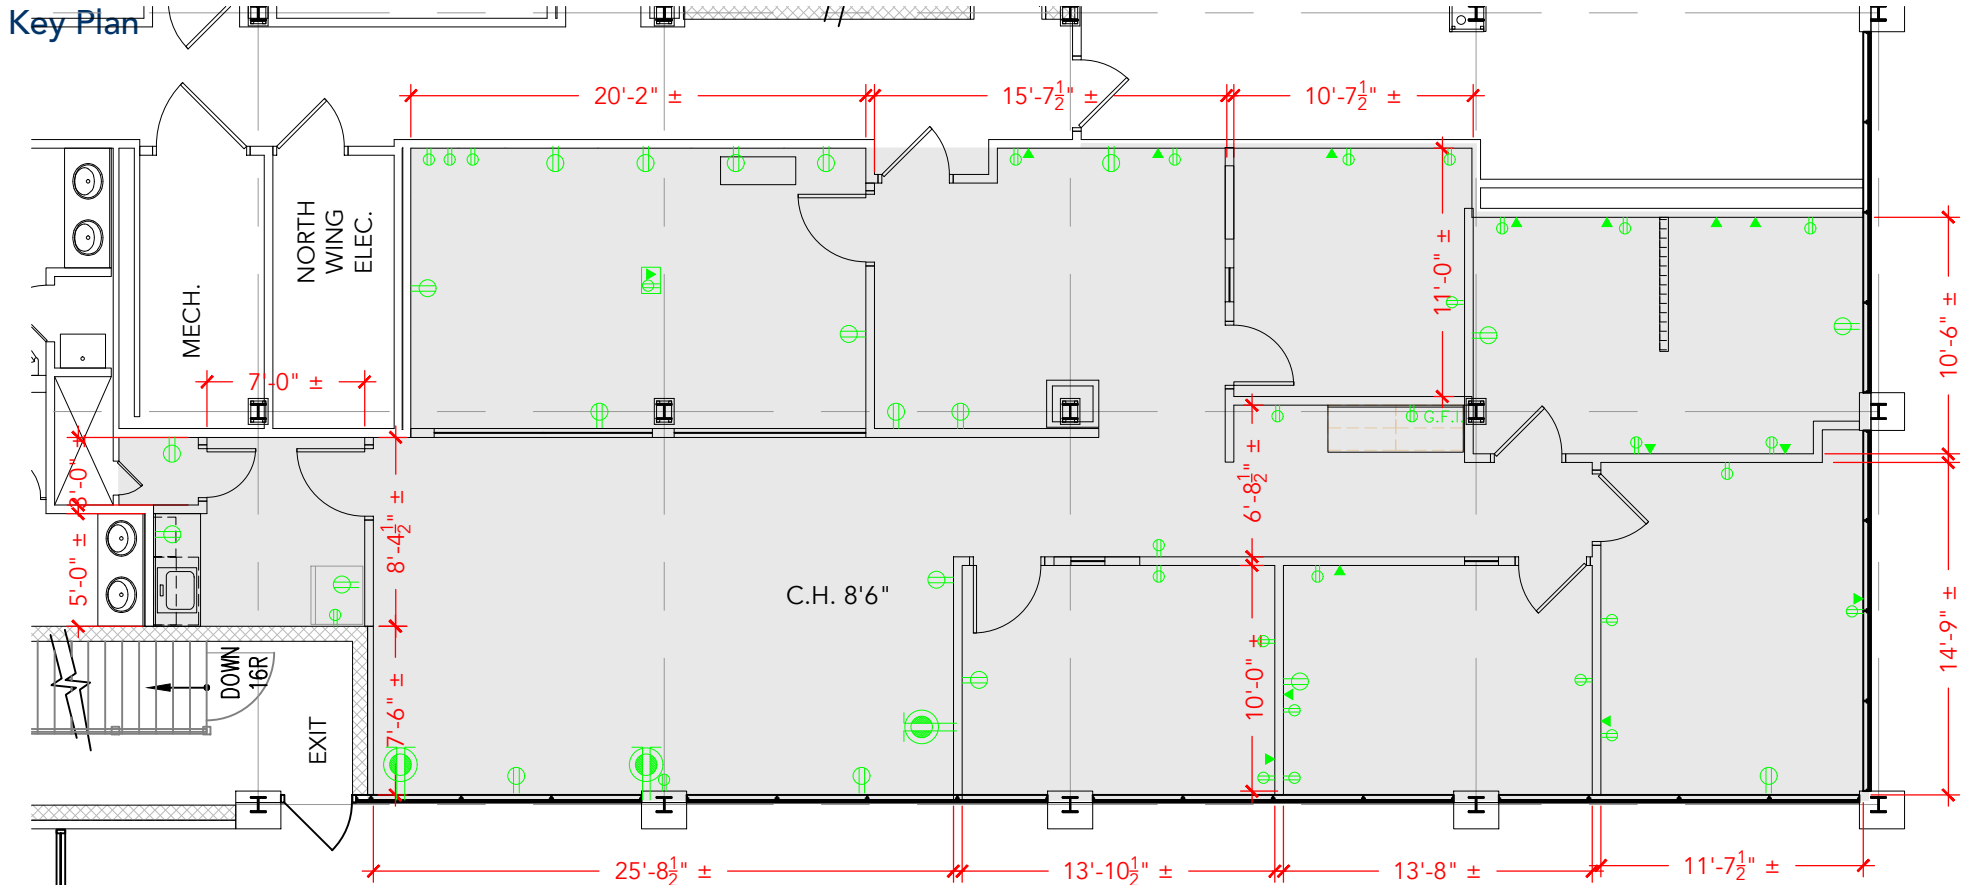

Floor Plan