


TOTAL SF AVAILABLE - 2,800 RSF (12.6%)

[Click to access 3D model](#)

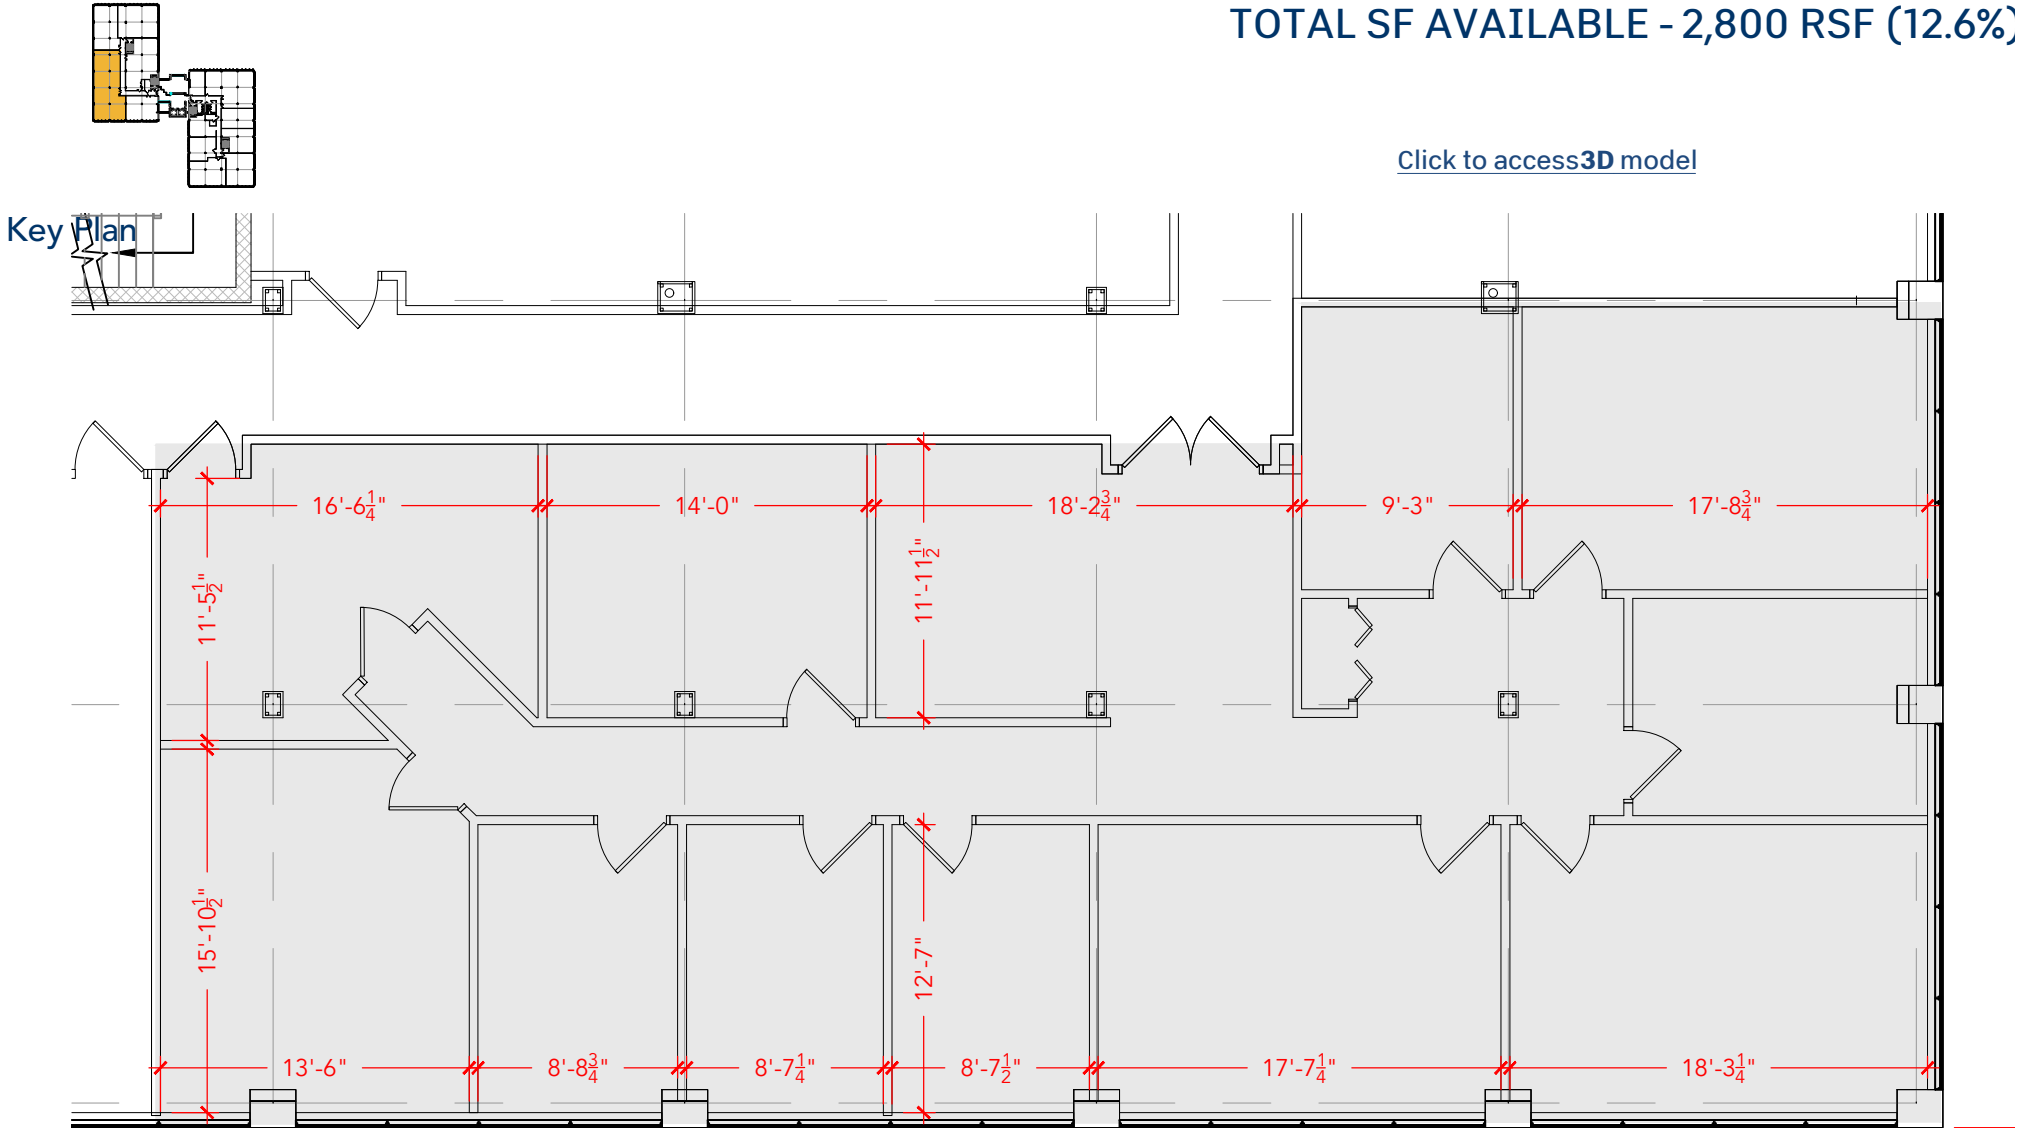

## Floor Plan