


TOTAL SF AVAILABLE - 1,074 RSF(12.6%)

[Click to access CADD file](#)

Key Plan

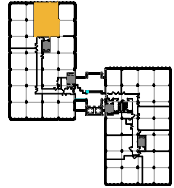

Floor Plan

