



TOTAL SF AVAILABLE - 562 RSF

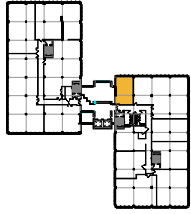

Key Plan

[Click to access 3D model](#)

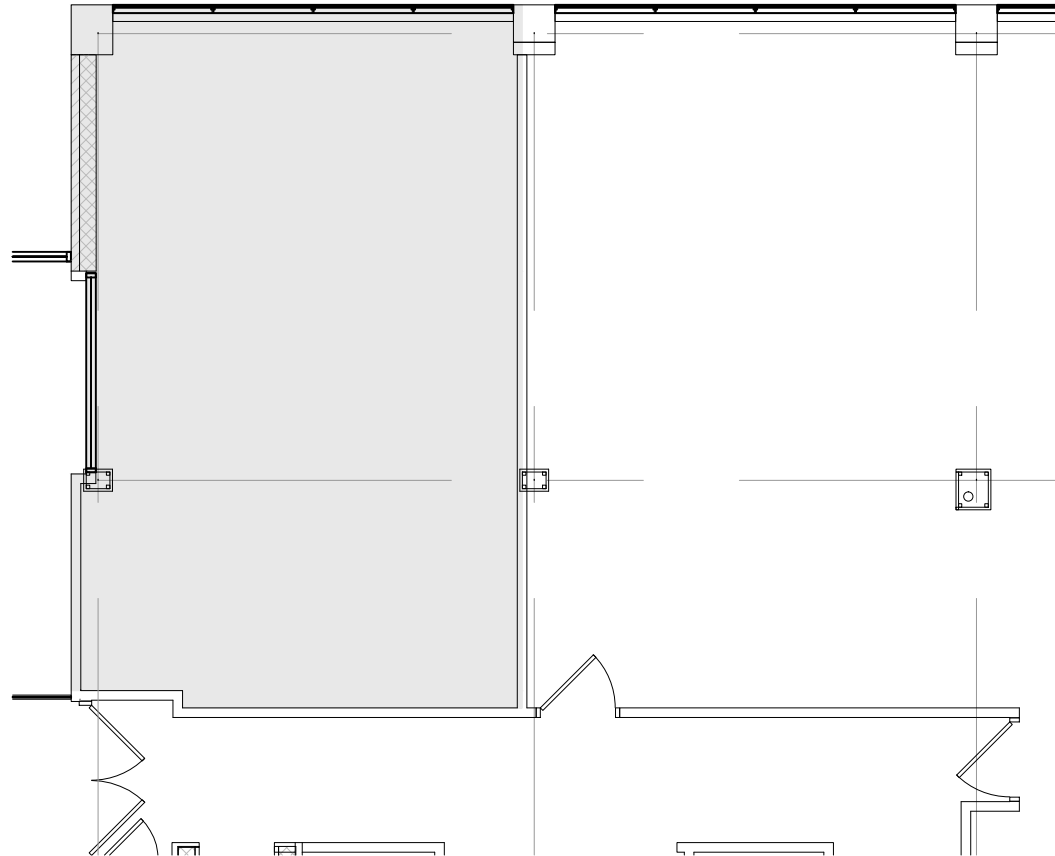

Floor Plan