



TOTAL SF AVAILABLE - 562 RSF (12.6%)

[Click to access CADD file](#)

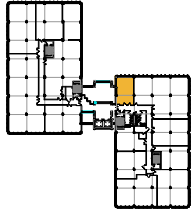

Key Plan

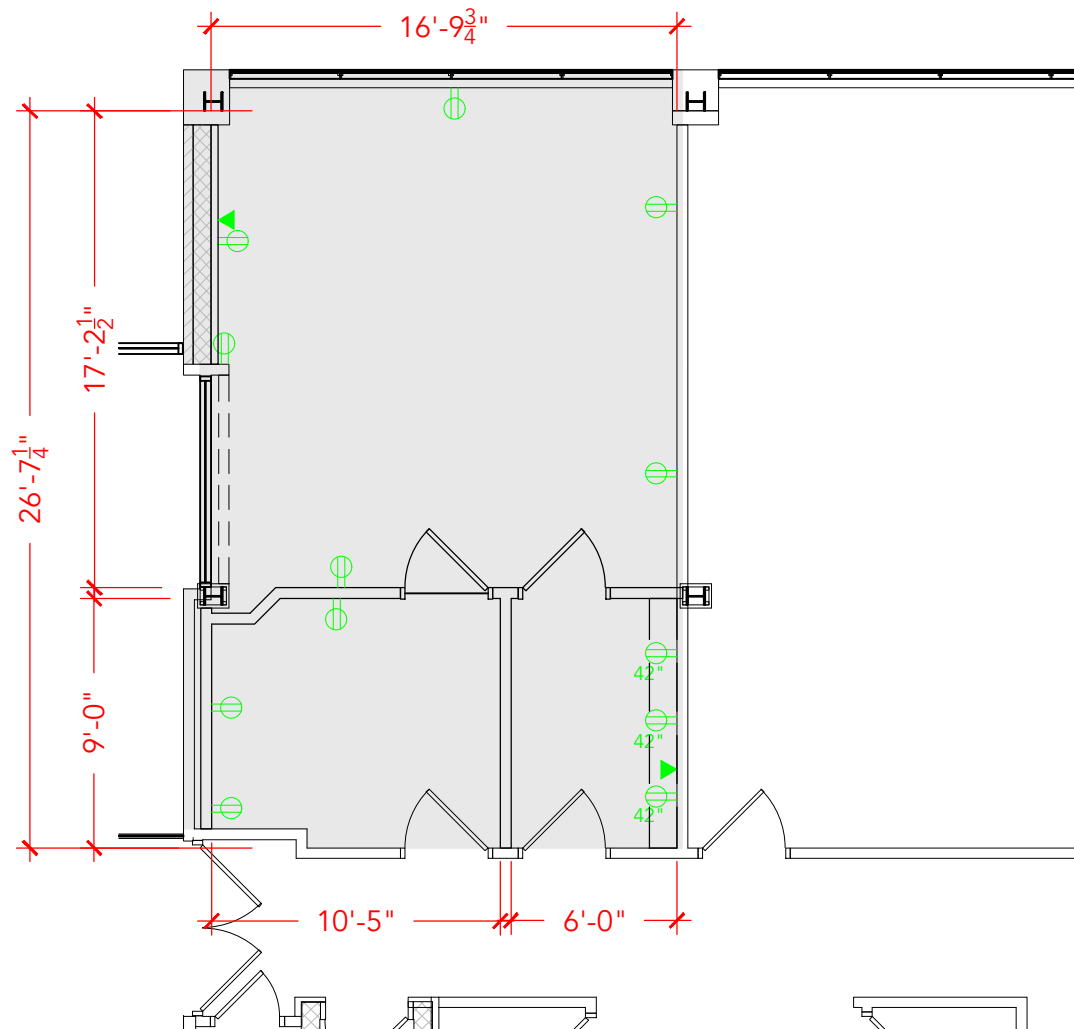

Floor Plan