



TOTAL SF AVAILABLE -1,056 RSF(12.6%)

[Click to access CADD file](#)

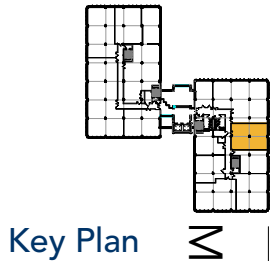

MENS

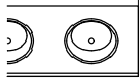

EC.

Floor Plan

