


Key Plan

TOTAL SF AVAILABLE - 783 RSF (12.6%)

[Click to access 3D model](#)

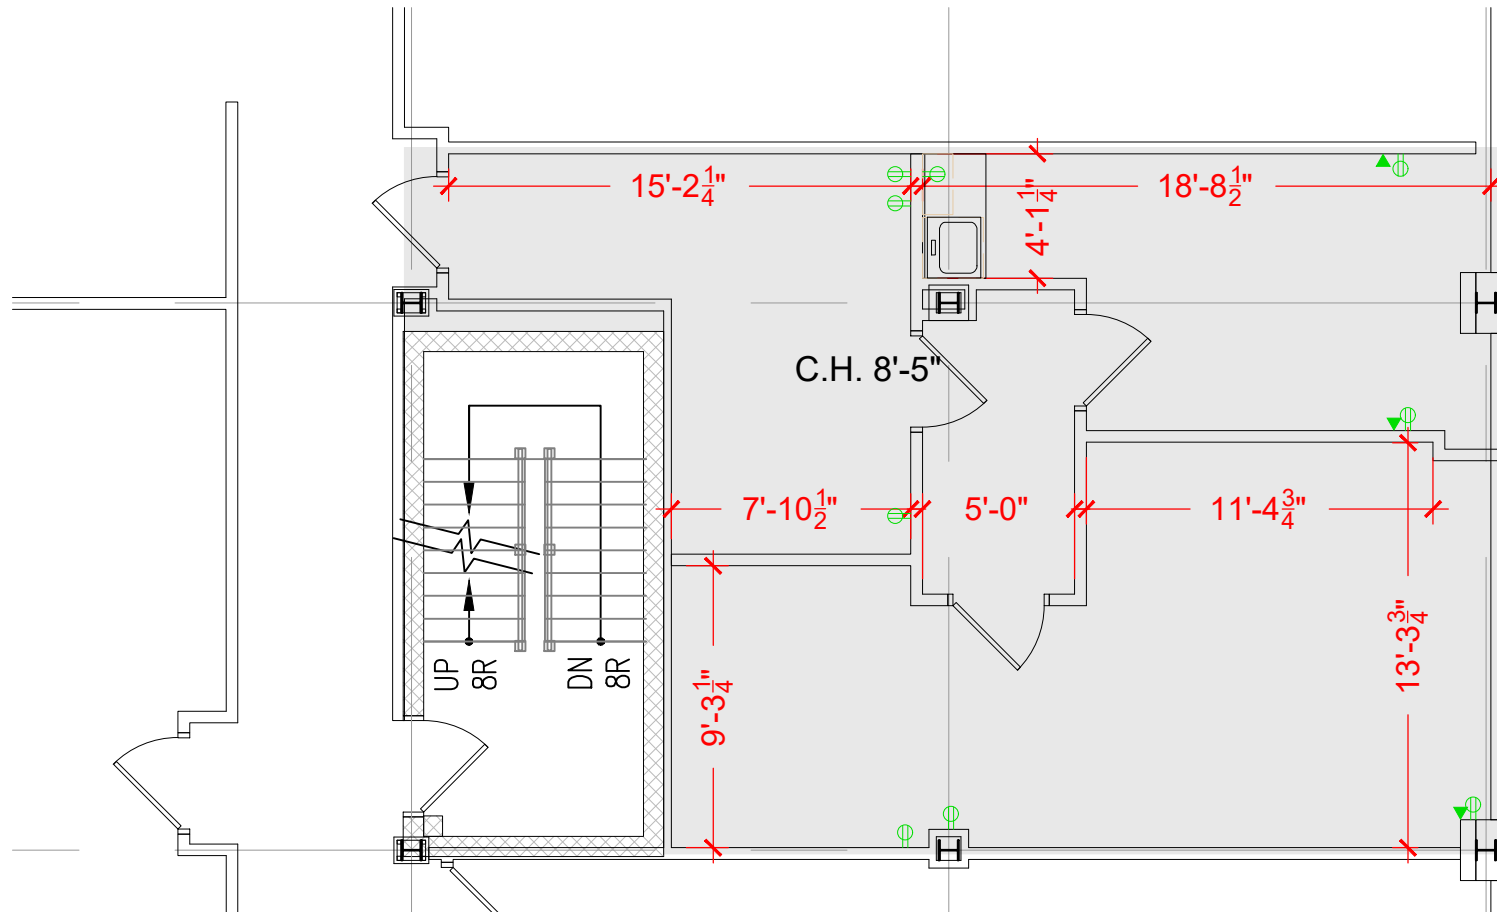

Floor Plan