



TOTAL SF AVAILABLE - 1,436 RSF(12.6%)

[Click to access 3D model](#)

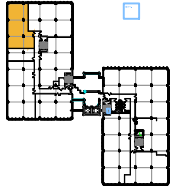

Key Plan

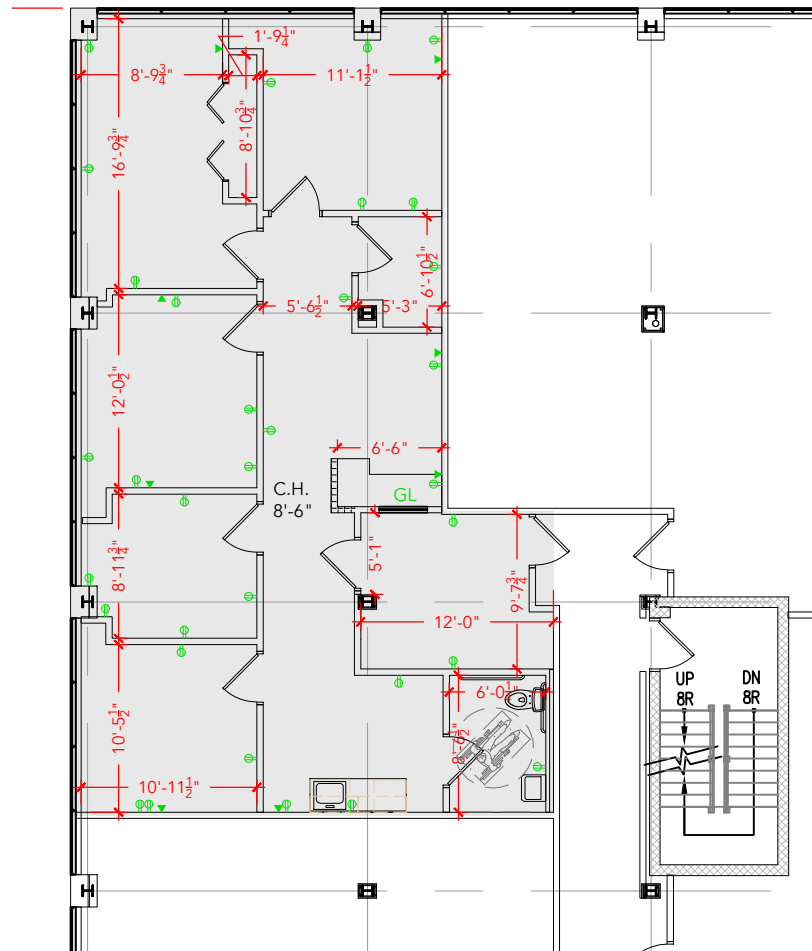

Floor Plan