



TOTAL SF AVAILABLE - 3,350 RSF (12.6%)

[Click to access 3D model](#)

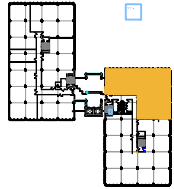

Key Plan

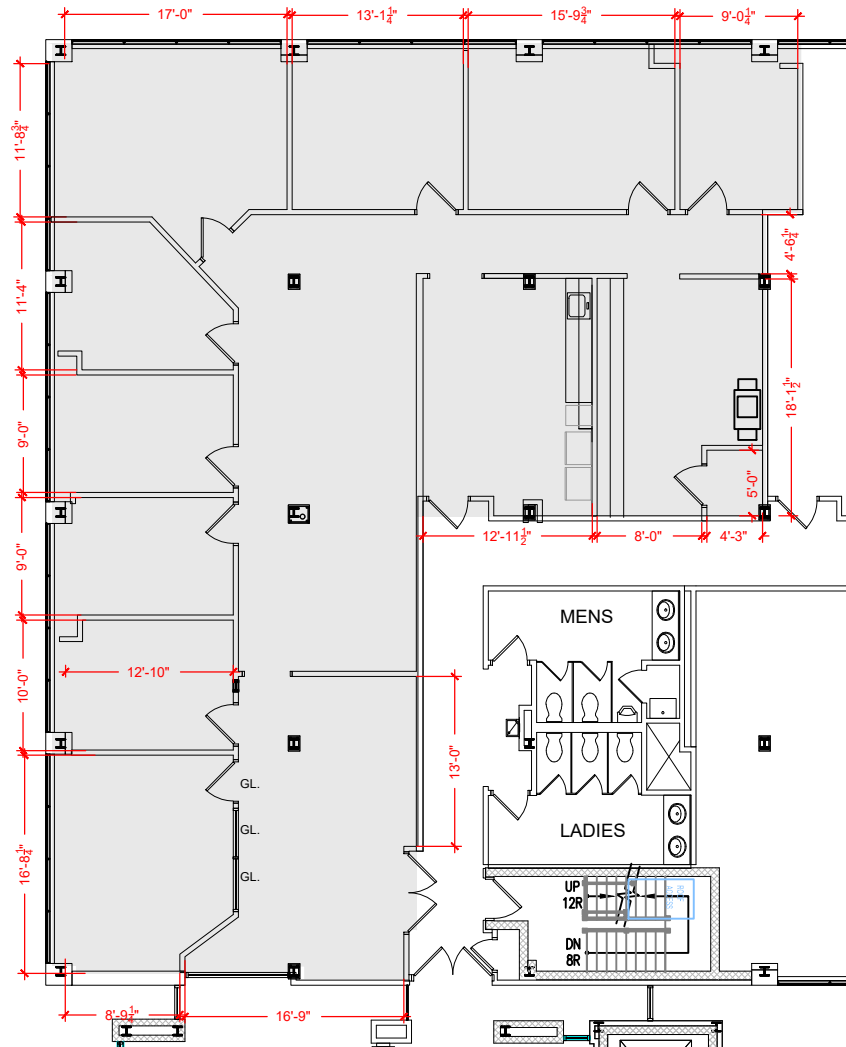

Floor Plan