



TOTAL SF AVAILABLE -2,545 RSF (12.6%)

[Click to access 3D model](#)

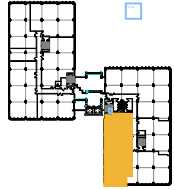

Key Plan

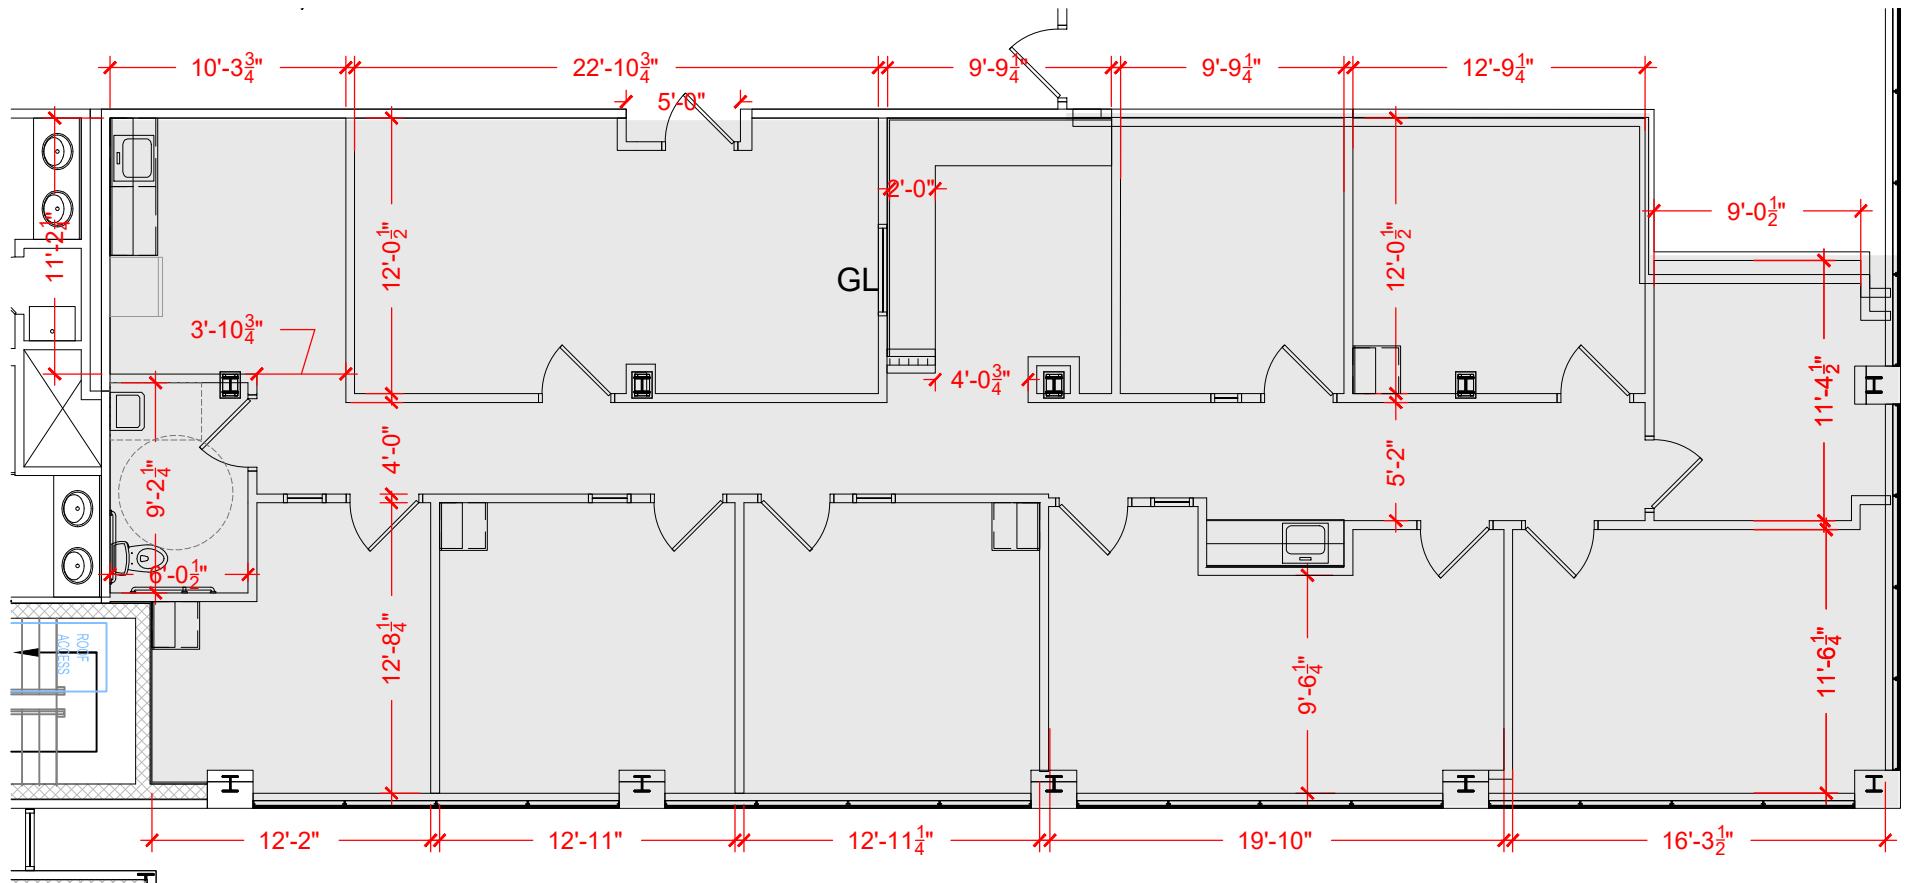

Floor Plan