


TOTAL SF AVAILABLE - 1,172 RSF(12.6%)



[Click to access 3D model](#)

Key Plan

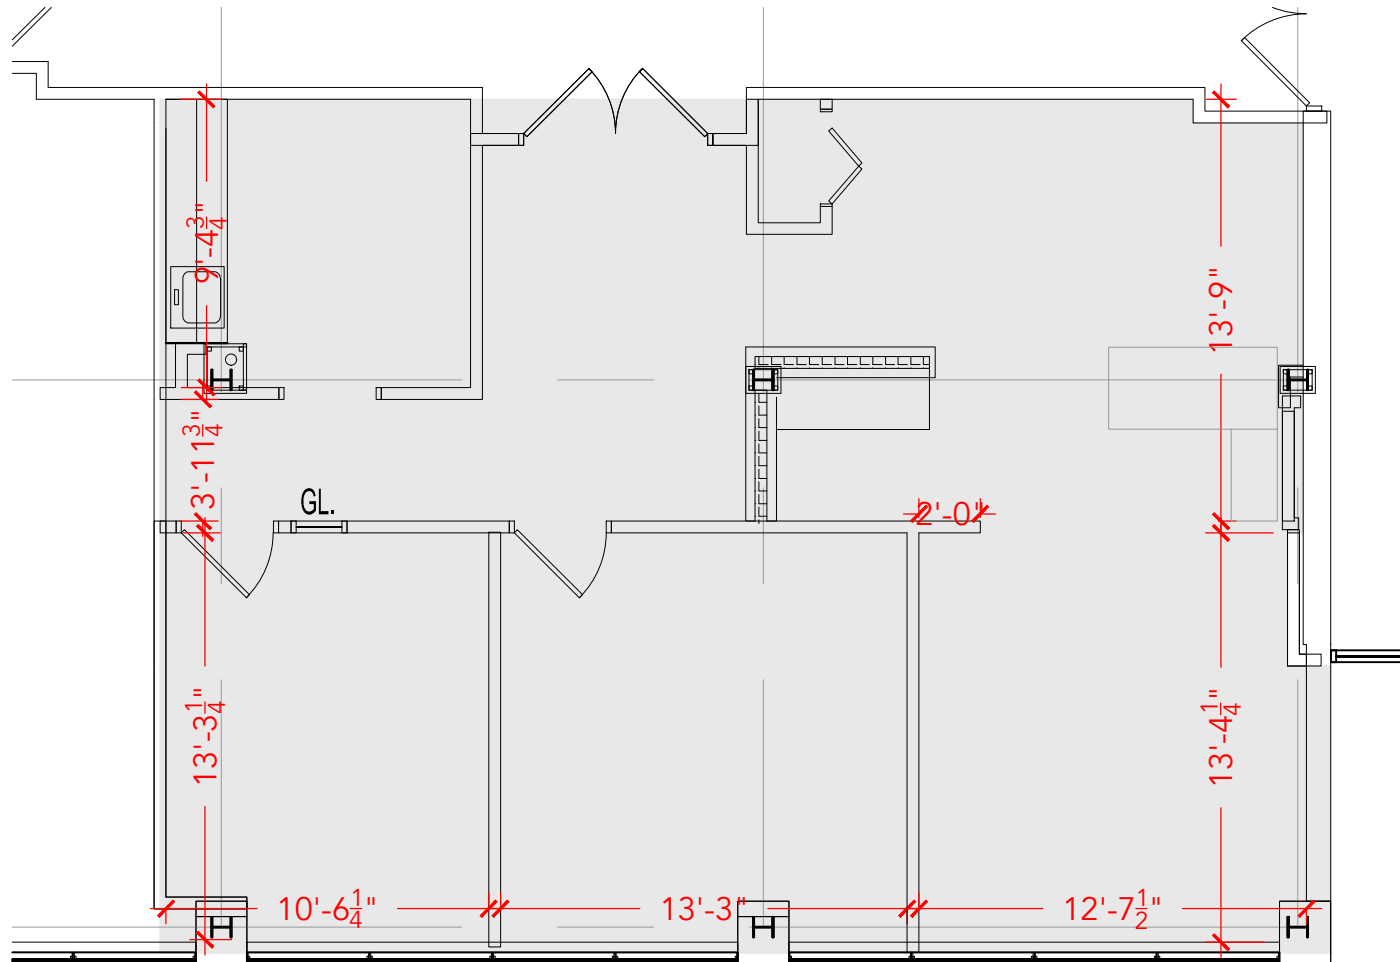

Floor Plan