


TOTAL SF AVAILABLE - 2,798 RSF (12.6%)

[Click to access 3D model](#)

Key Plan

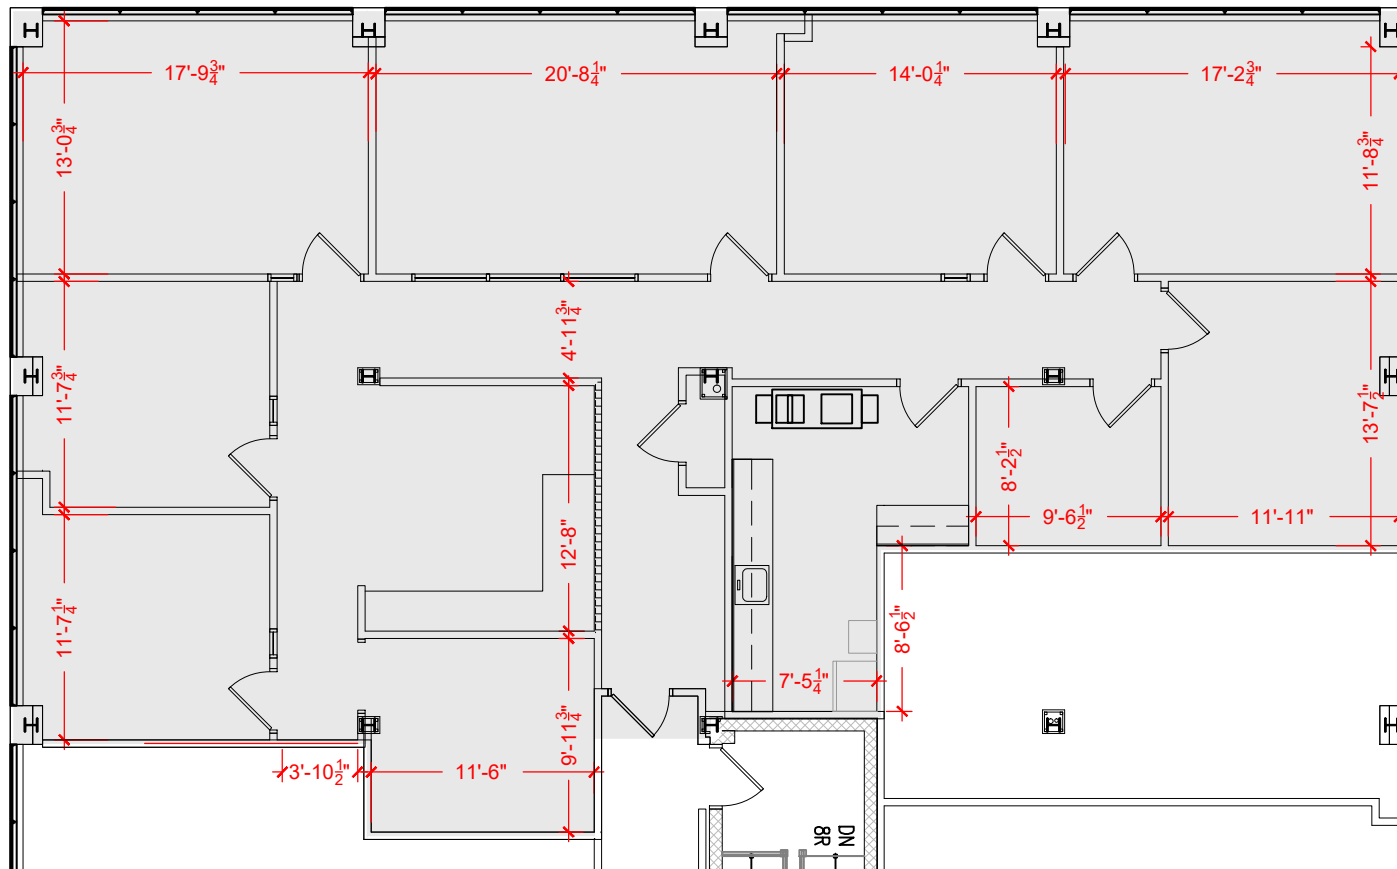

Floor Plan