
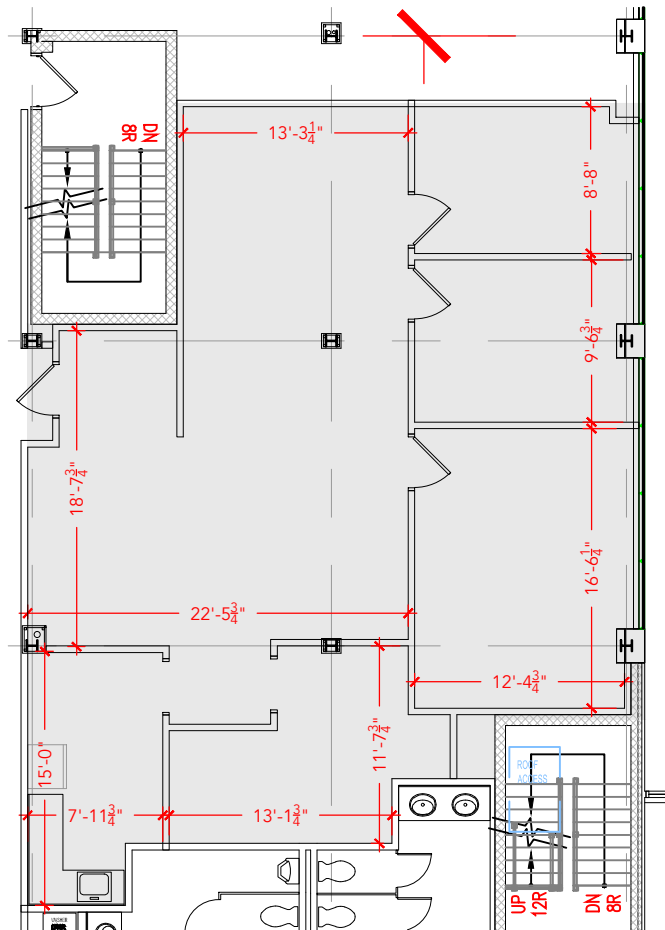


TOTAL SF AVAILABLE - 1,588 RSF(12.6%)

[Click to access 3D model](#)

Key Plan

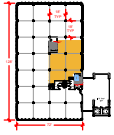

Floor Plan