
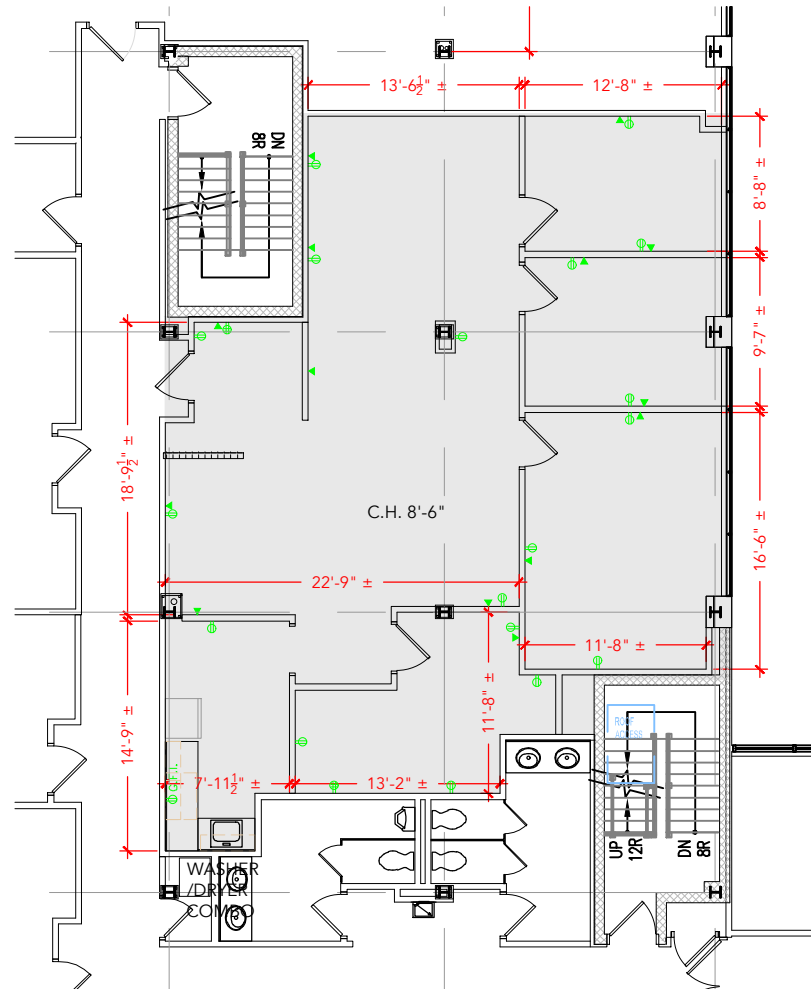


TOTAL SF AVAILABLE -1,588 RSF(12.6%)

[Click to access CADD file](#)

Key Plan

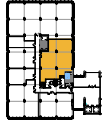

Floor Plan