


TOTAL SF AVAILABLE - 2,842 RSF



[Click to access 3D model](#)

Key Plan

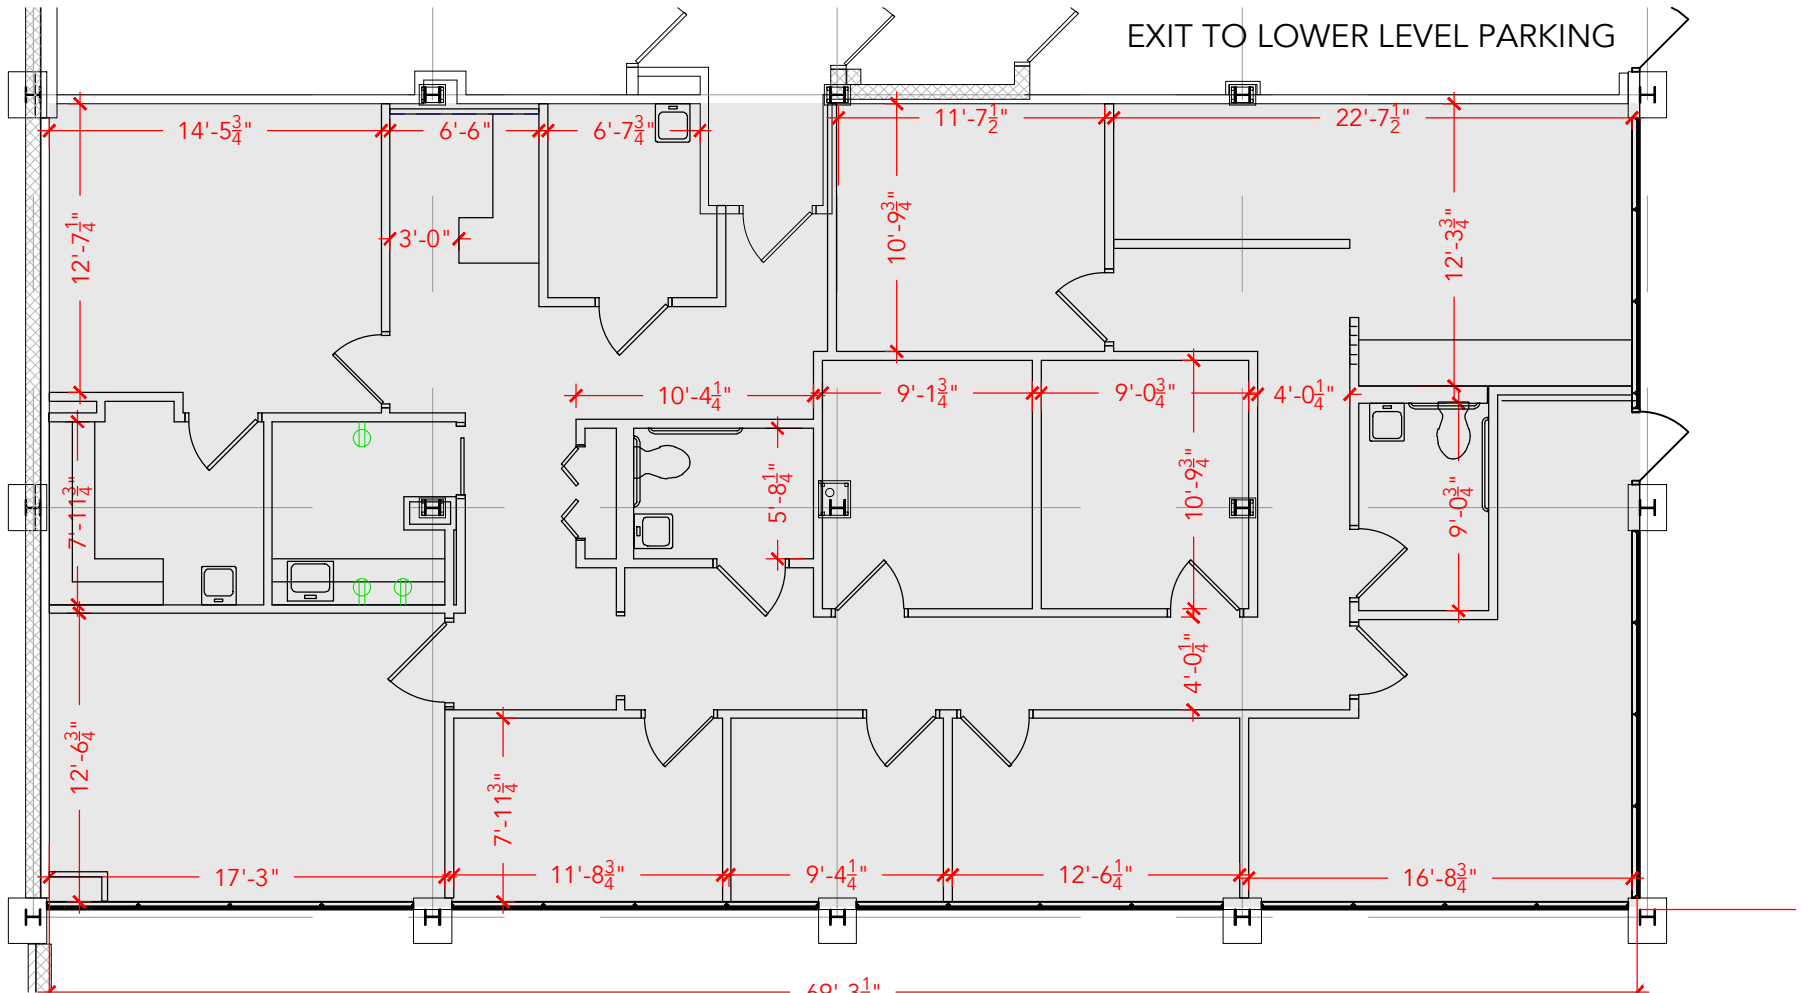

Floor Plan