

TOTAL SF AVAILABLE - 1,622 SF

OFFICE - 1,622 SF


WAREHOUSE - 0,000 SF

[Click to access 3D model](#)



Key Plan

109

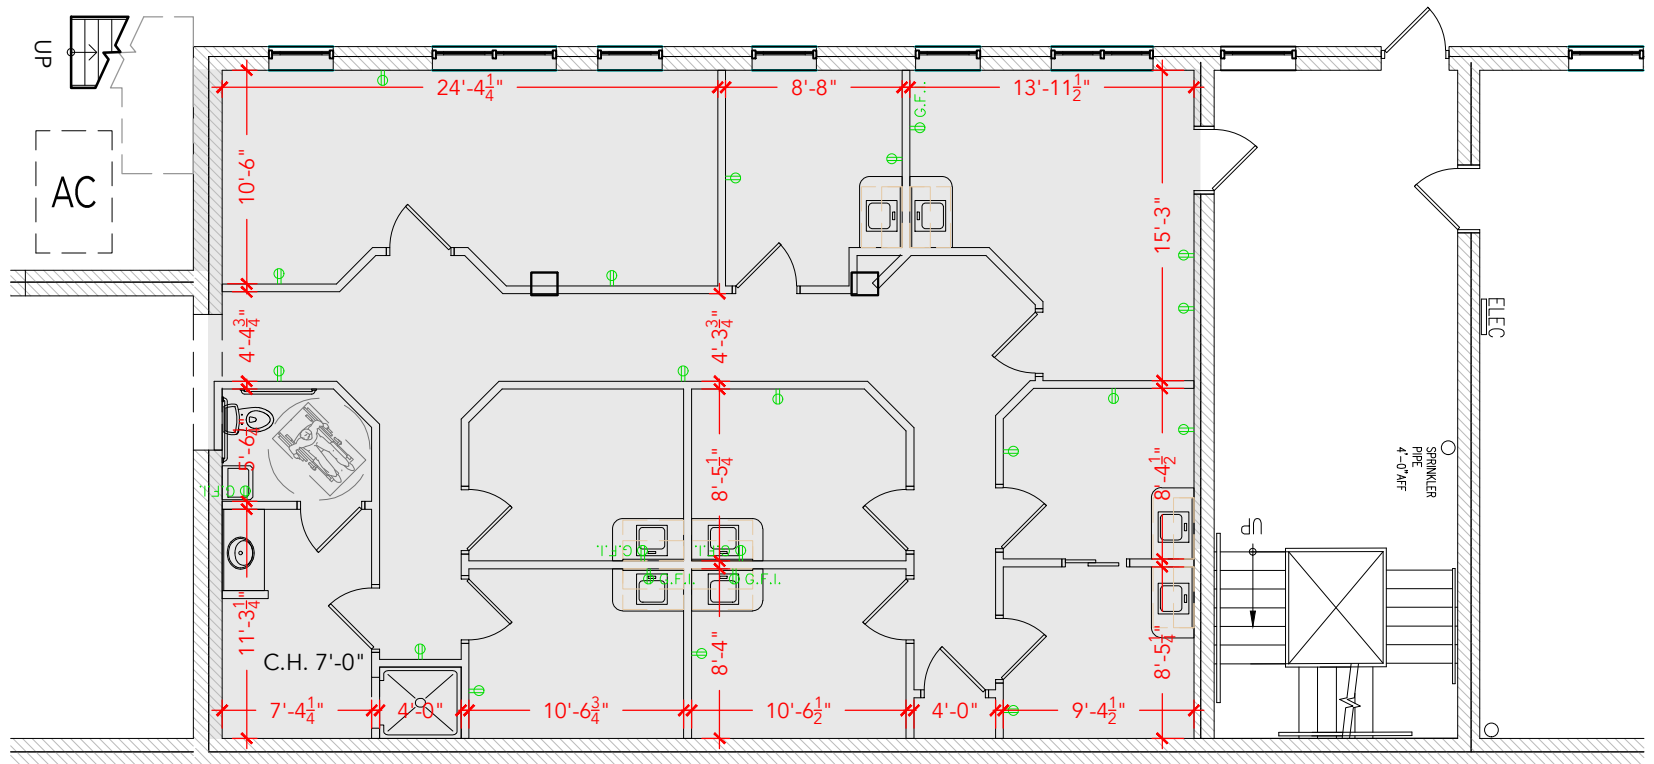

Floor Plan