




TOTAL SF AVAILABLE - 1,622 SF

OFFICE - 1,622 SF

WAREHOUSE - 0 SF

[Click to access 3D model](#)

Key Plan

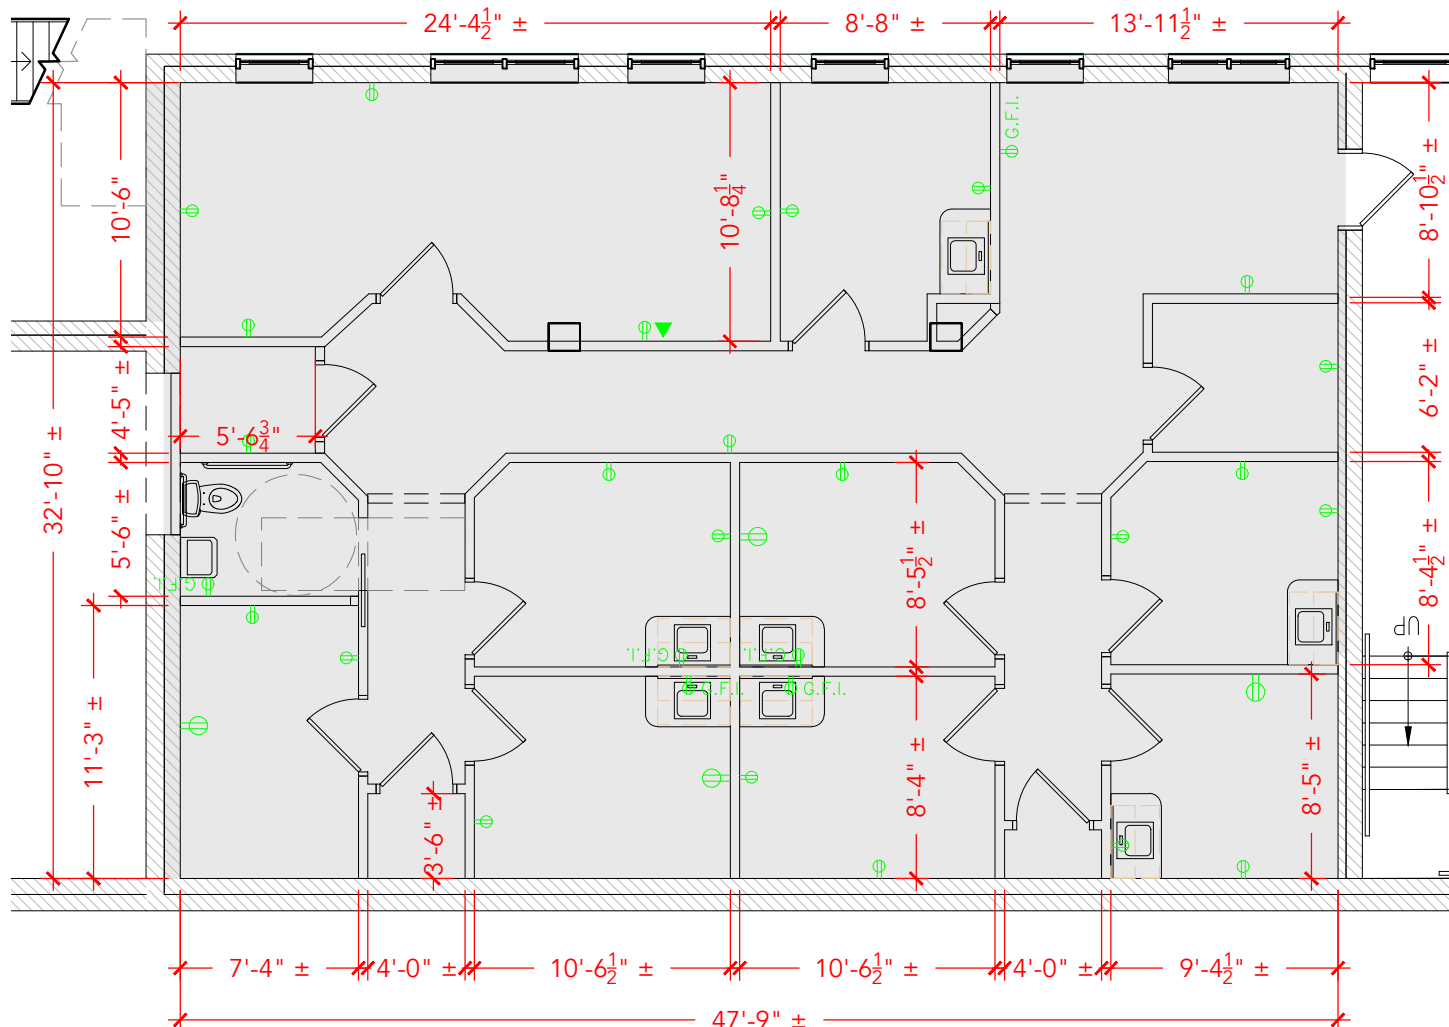

Floor Plan