


TOTAL SF AVAILABLE - 4,397 SF

[Click to access 3D model](#)



Key Plan

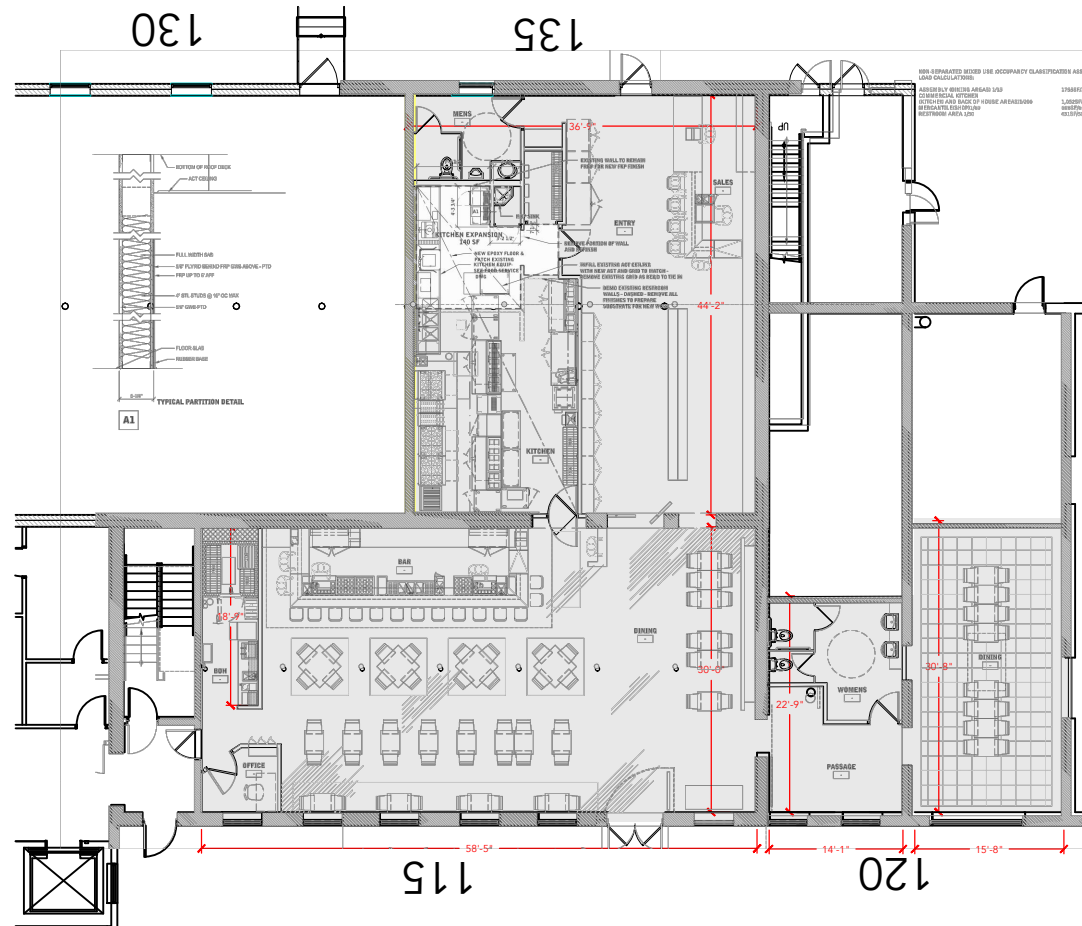

Floor Plan