


TOTAL SF AVAILABLE - 2,150 RSF (12%)

[Click to access CADD file](#)



Key Plan

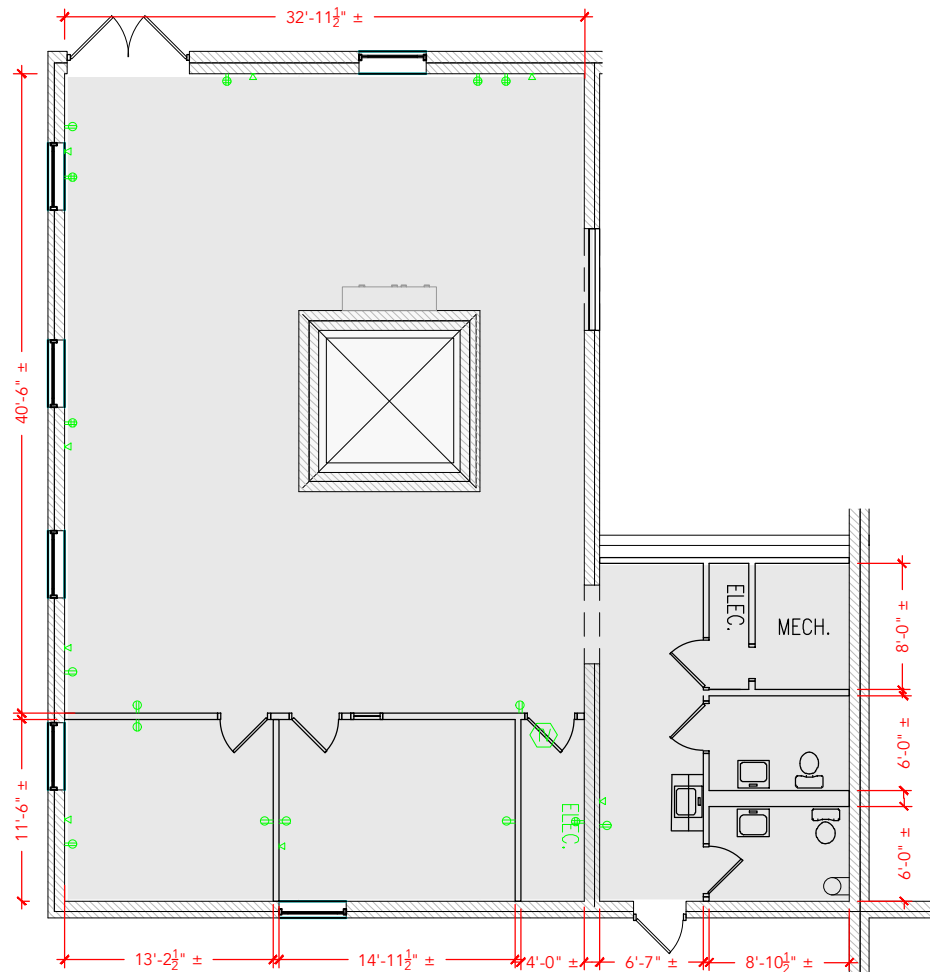

Floor Plan