


TOTAL SF AVAILABLE - 2,080 SF

[Click to access 3D model](#)

Key Plan

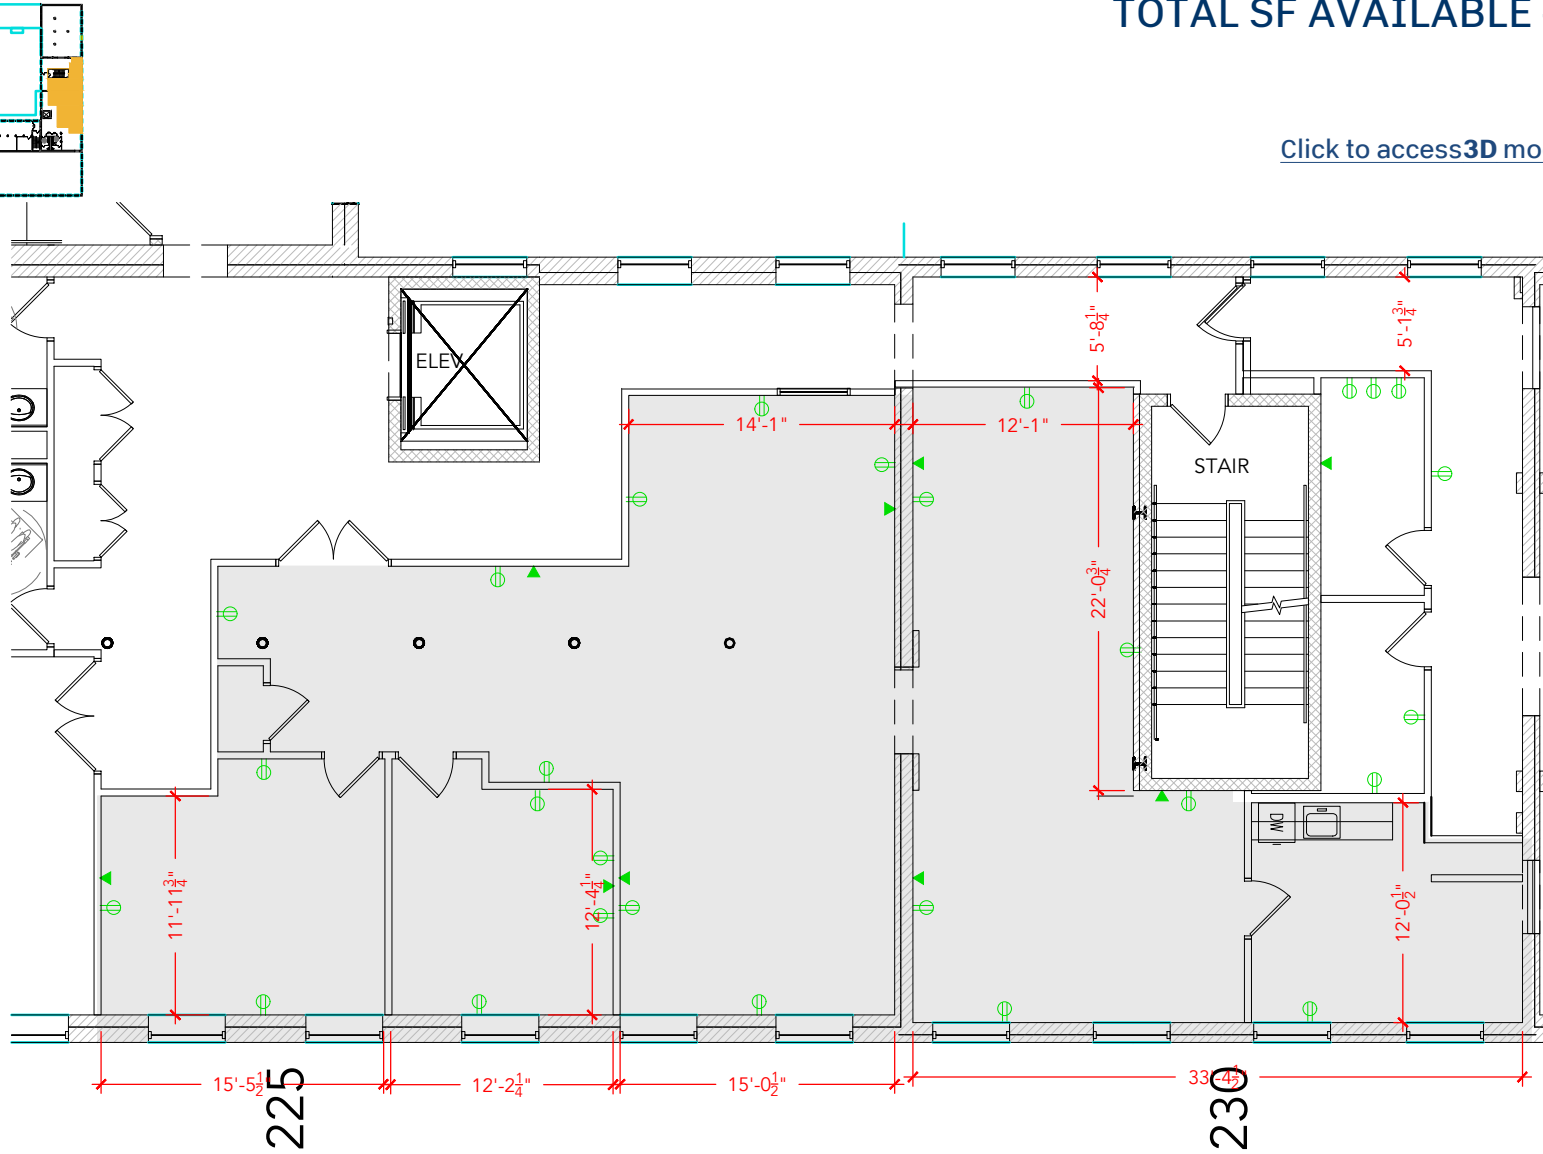

Floor Plan