



TOTAL SF AVAILABLE -2,494 RSF(12%)

[Click to access CADD file](#)

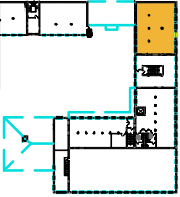

Key Plan

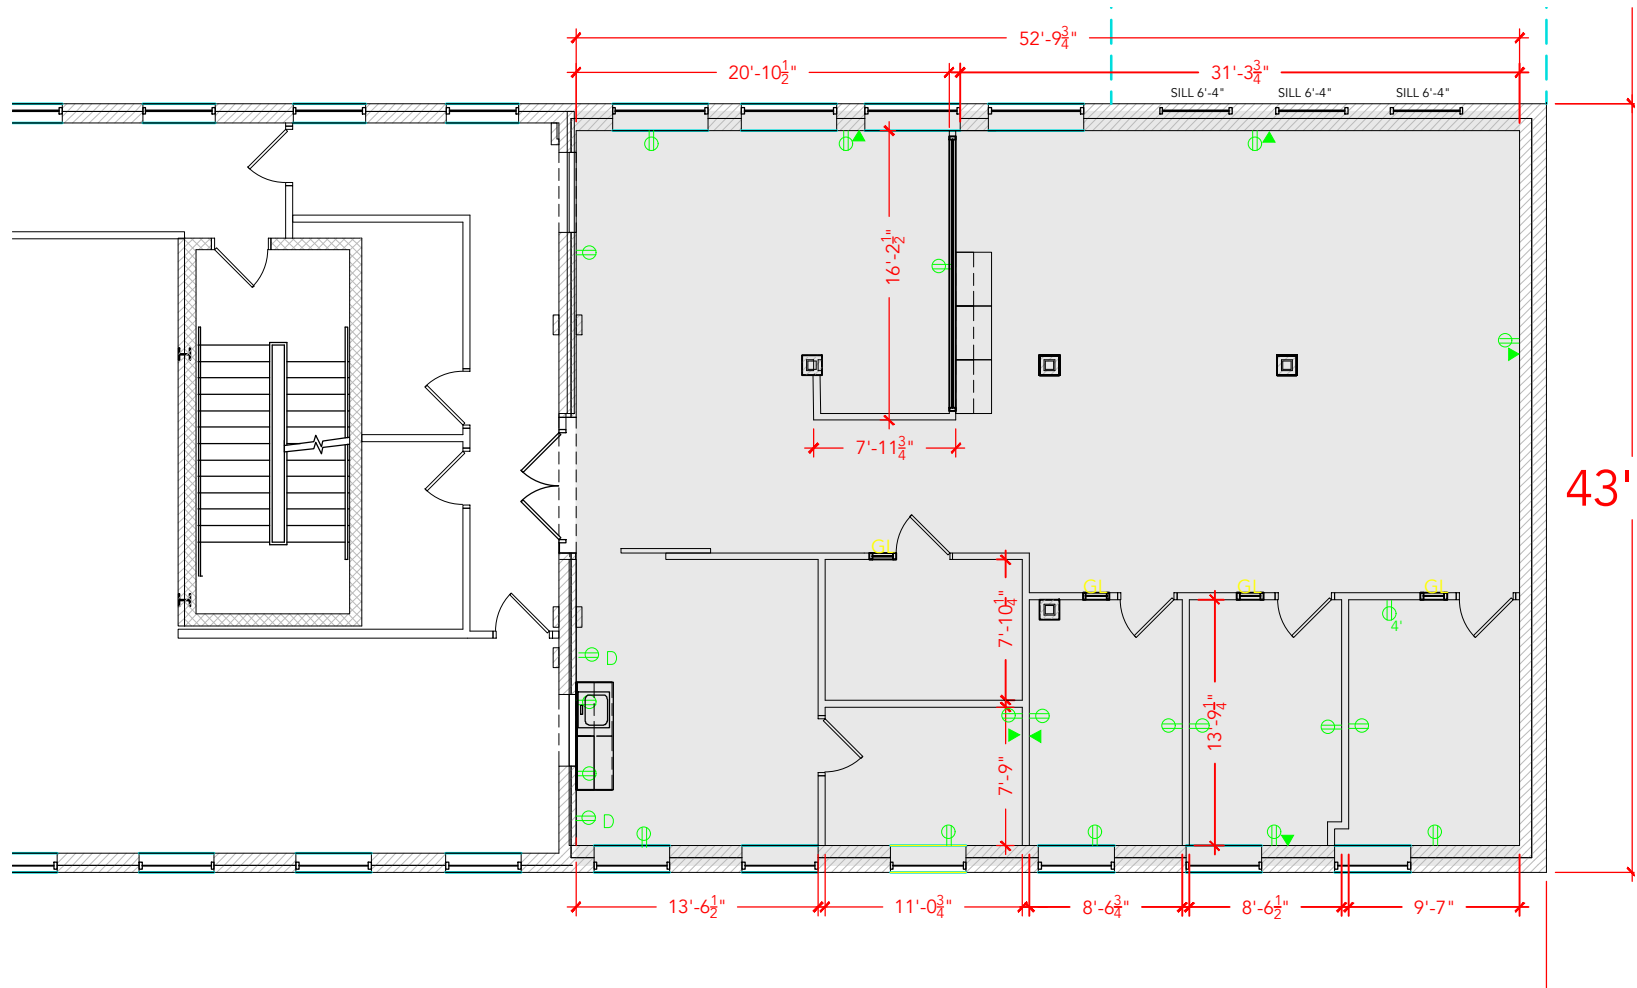

Floor Plan