



TOTAL SF AVAILABLE - 3,170 RSF (12%)

[Click to access 3D model](#)

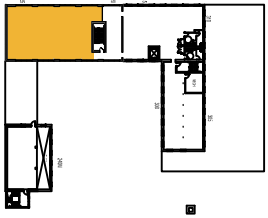

Key Plan

325

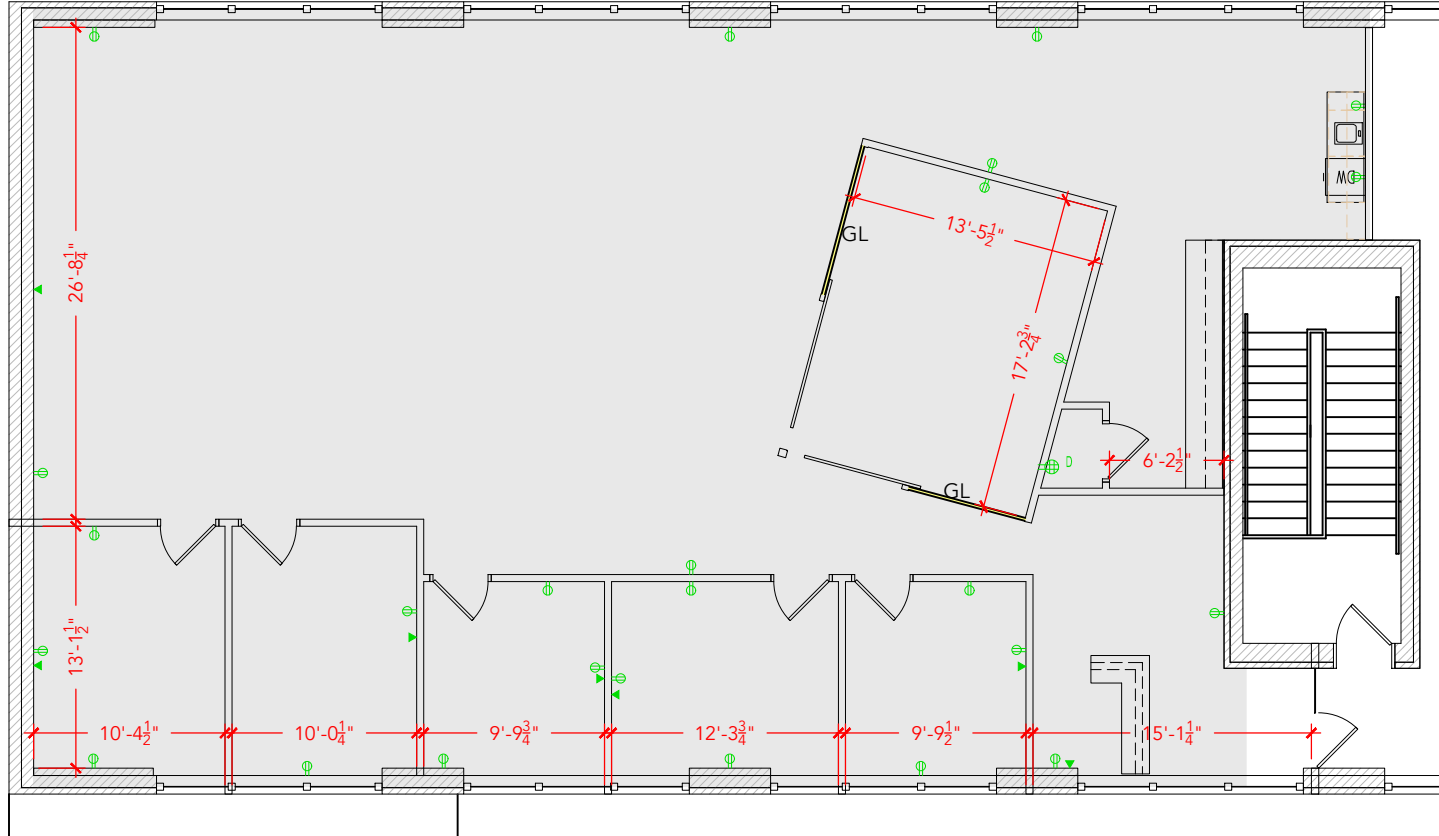

Floor Plan