


**TOTAL SF AVAILABLE - 3,600 SF**


OFFICE - 891 SF

WAREHOUSE - 2,709 SF

[Click to access 3D model](#)

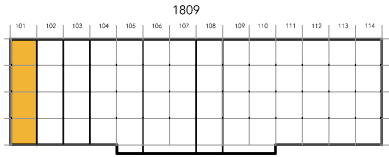

## Key Plan

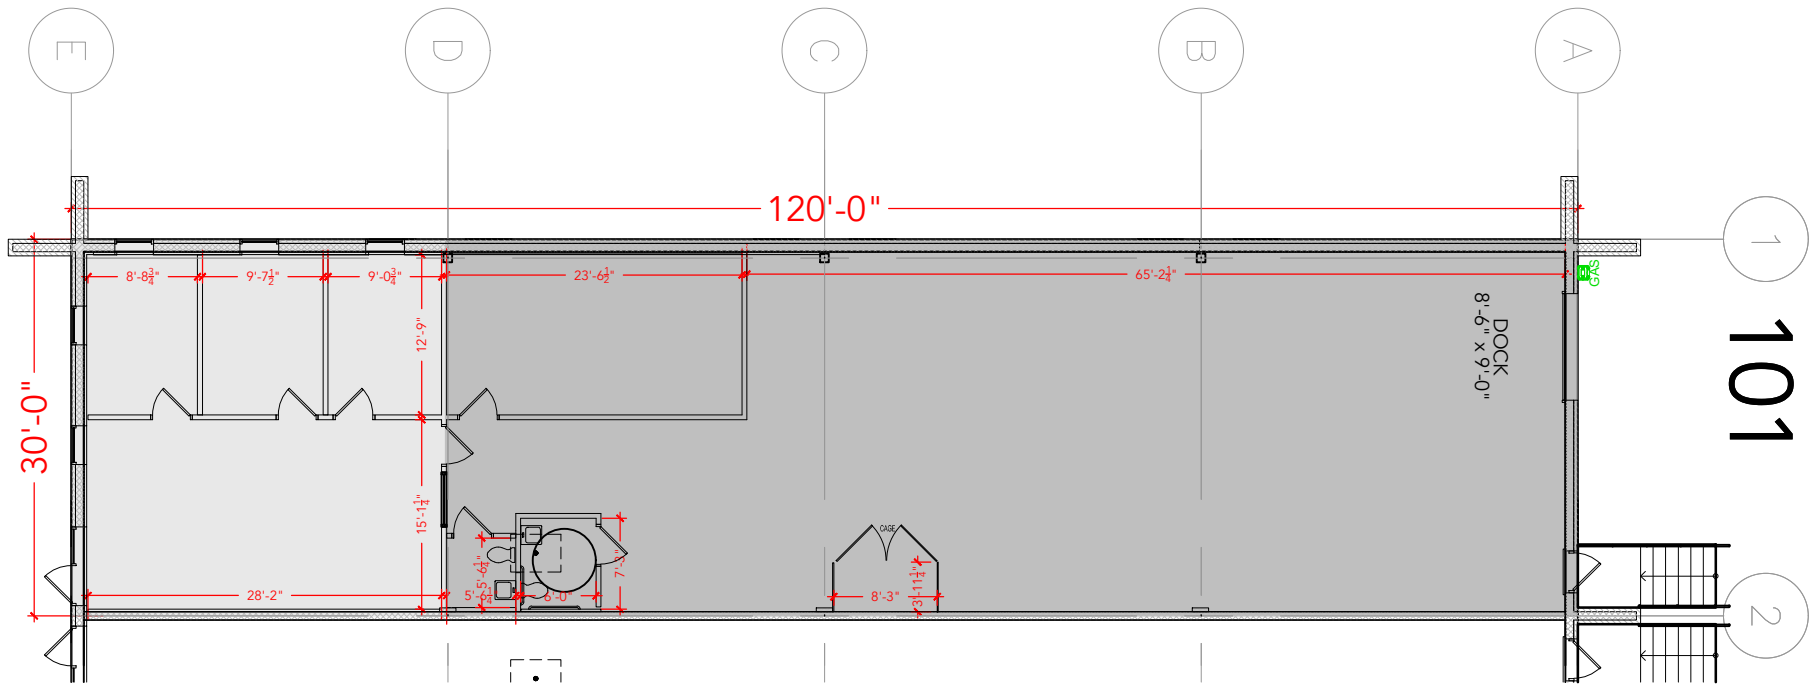

## Floor Plan