


TOTAL SF AVAILABLE - 3,600 SF


OFFICE - 1,385 SF

WAREHOUSE SF - 2,215 SF

[Click to access 3D model](#)

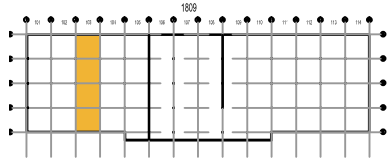

Key Plan

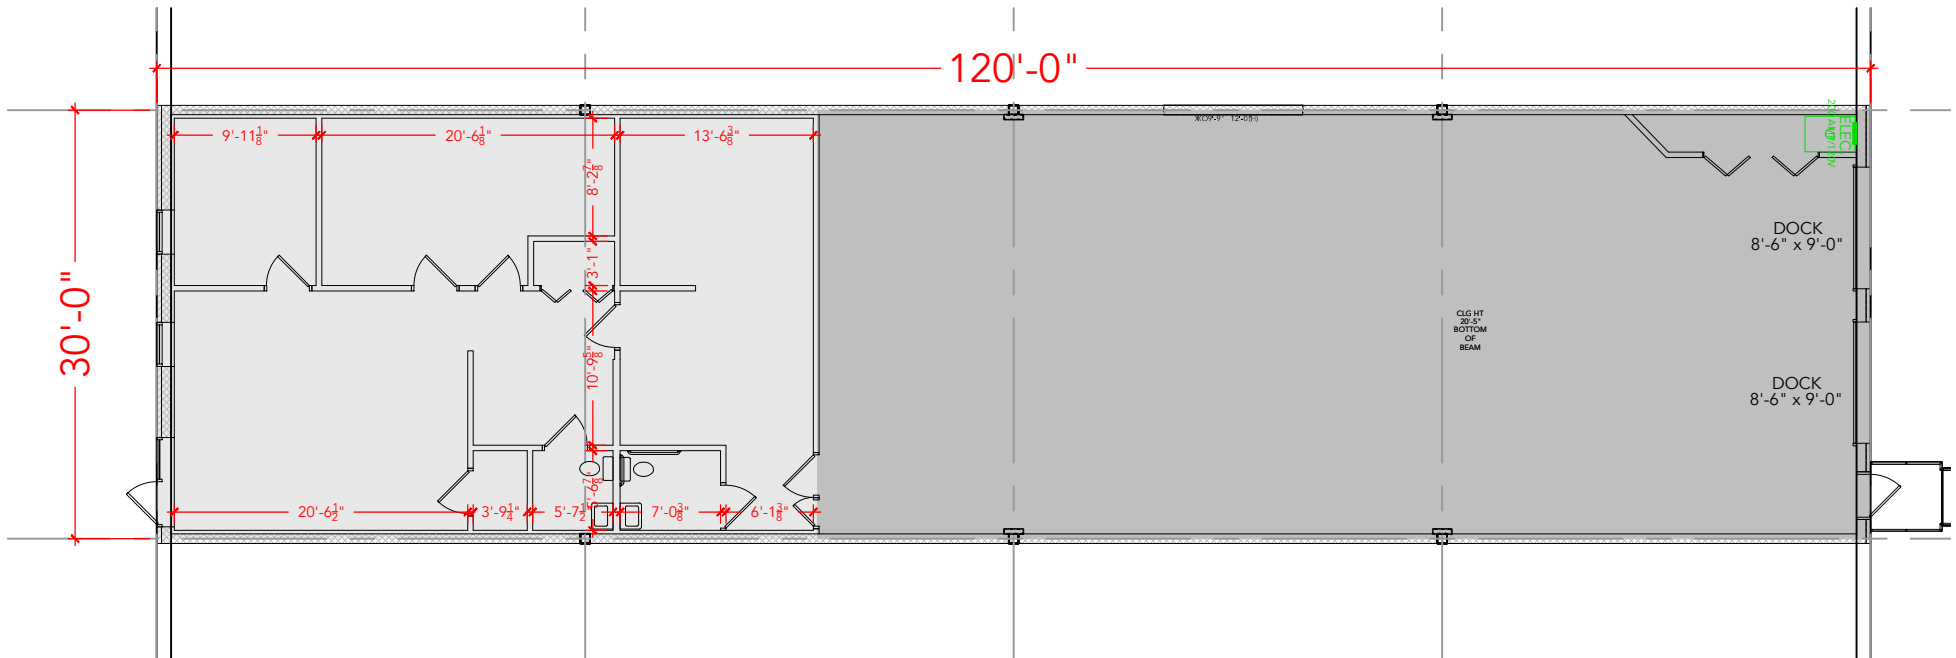

Floor Plan