


TOTAL SF AVAILABLE - 3,900 SF

OFFICE - 1,215 SF



WAREHOUSE SF - 2,685 SF

* 1,451 MEZZ SF NOT INCLUDED IN TOTAL SF

[Click to access 3D model](#)

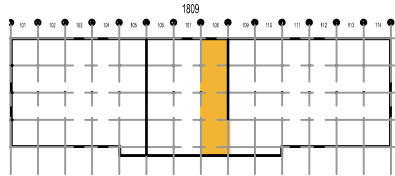

Key Plan

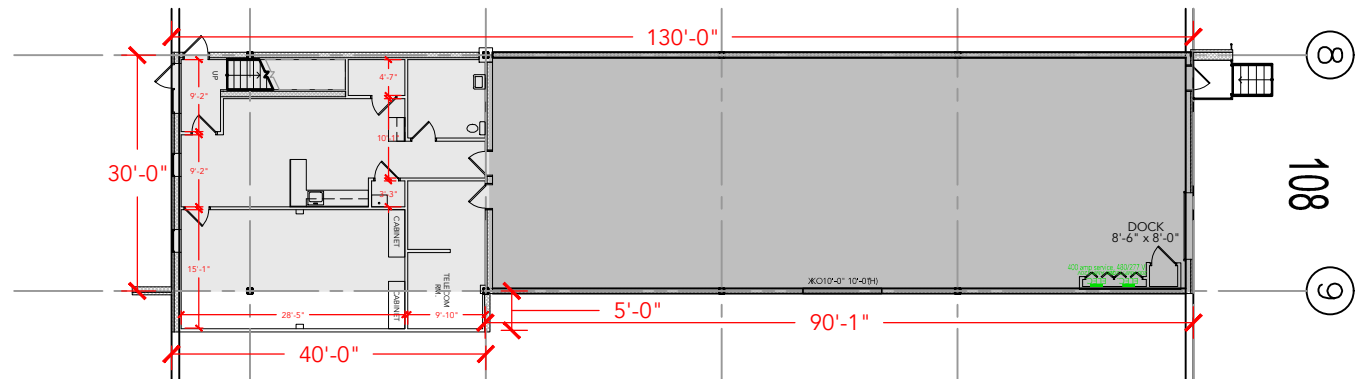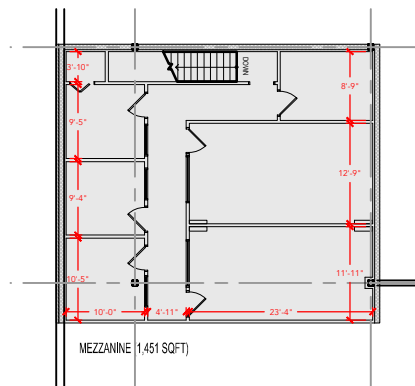

Floor Plan