


TOTAL SF AVAILABLE - 29,760 SF


OFFICE SF - 0,000 SF

WAREHOUSE SF - 29,760 SF

[Click to access 3D model](#)

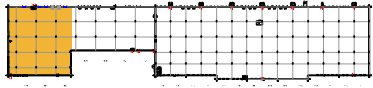

Key Plan

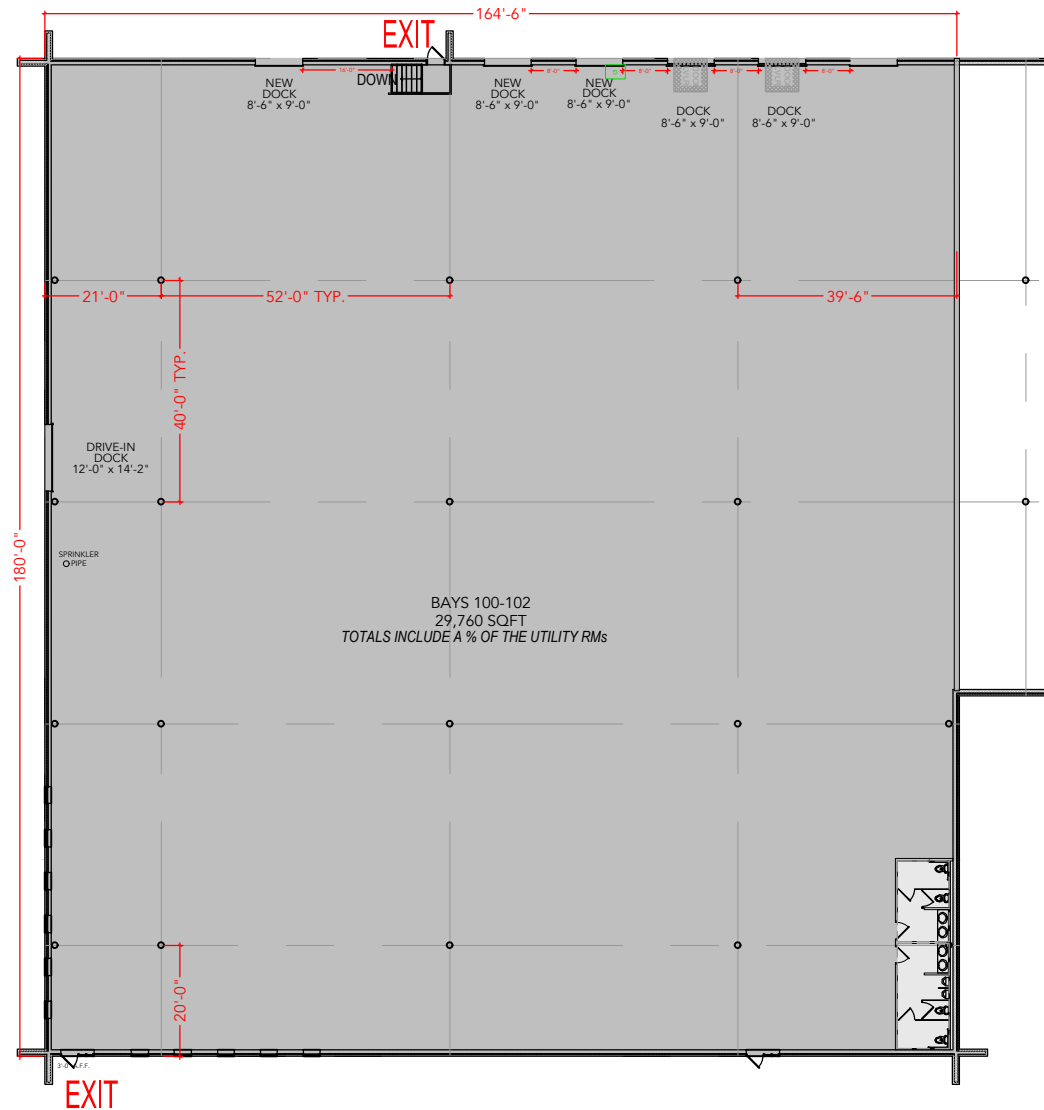

Floor Plan