


TOTAL SF AVAILABLE - 20,760 SF


RESTROOMS - 405 SF

WAREHOUSE - 29,355 SF

[Click to access 3D model](#)

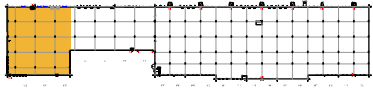

Key Plan

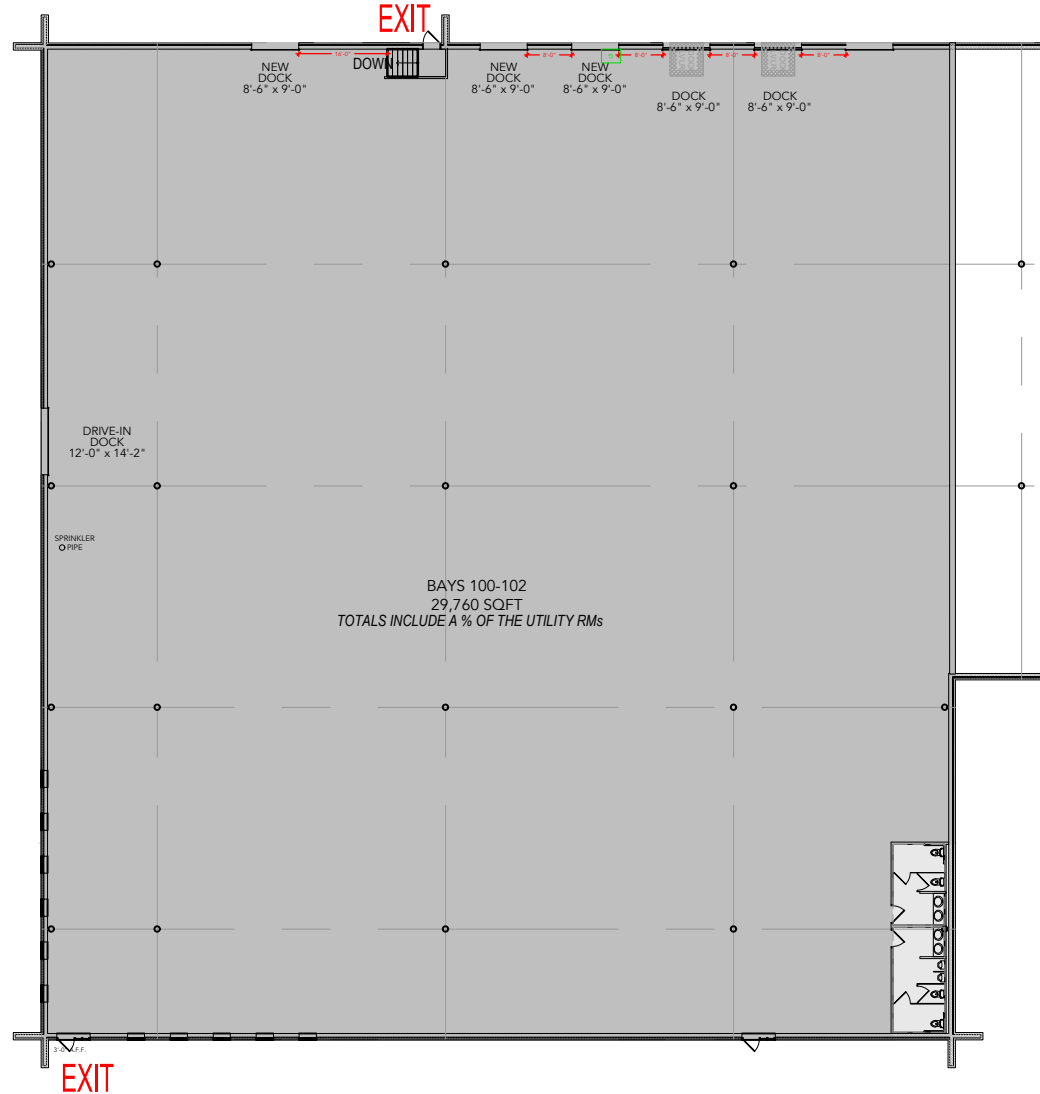

Floor Plan