

TOTAL SF AVAILABLE -29,760 SF


OFFICE - 1,988 SF

WAREHOUSE SF - 27,772 SF

TOTALS INCLUDE A % OF THE UTILITY RMs
[Click to access 3D model](#)



Key Plan

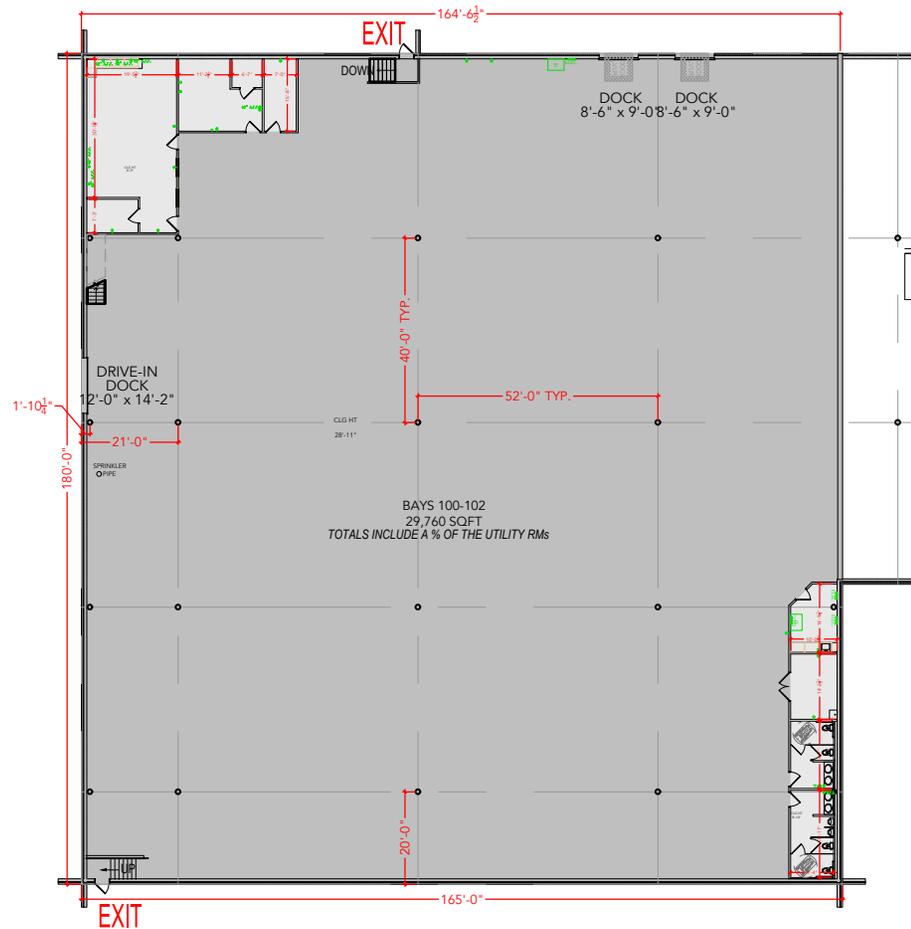

Floor Plan