


TOTAL SF AVAILABLE - 91,850 SF

1ST FLOOR OFFICE 17,248 SF

2ND FLOOR OFFICE 15,000 SF

WAREHOUSE 59,602 SF

[Click to access 3D model](#)

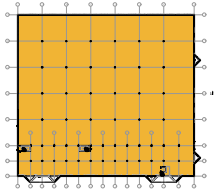

Key Plan



Floor Plan