


TOTAL SF AVAILABLE -1,805 RSF

OFFICE - 1,805 RSF

WAREHOUSE - 0,000 RSF


* INCLUDES % OF METER ROOM

[Click to access CADD file](#)

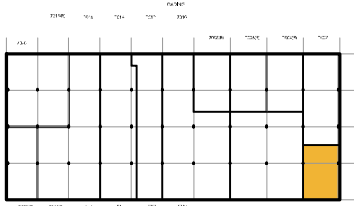

Key Plan

7002(F)

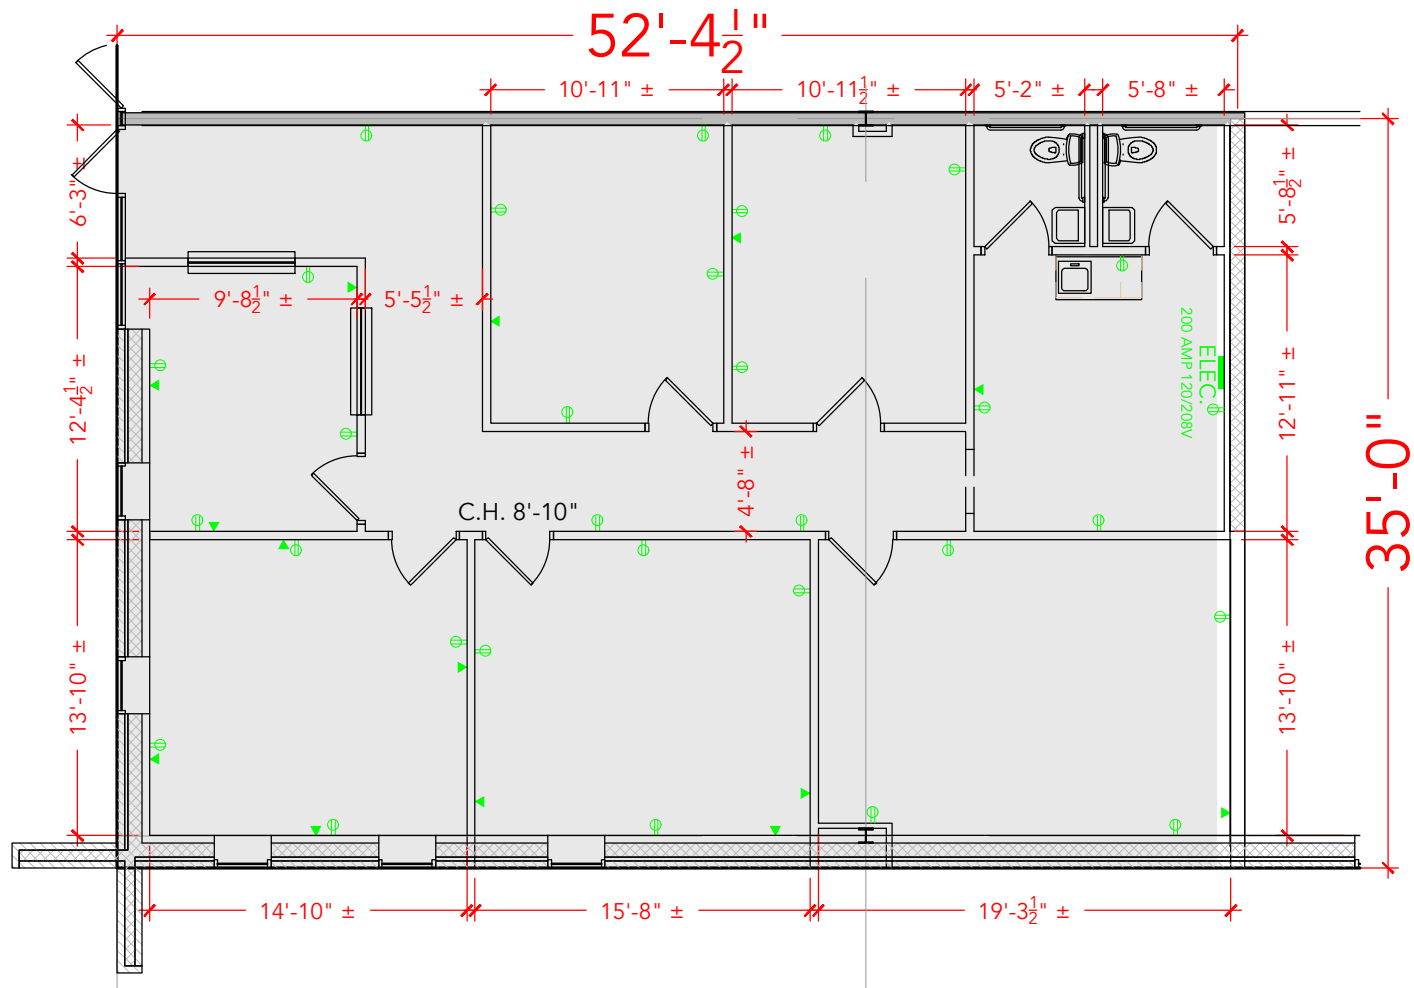

Floor Plan