


TOTAL SF AVAILABLE - 1,950 SF


OFFICE - 484 SF

WAREHOUSE - 1,466 SF

[Click to access 3D model](#)

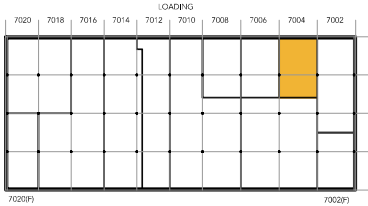

Key Plan

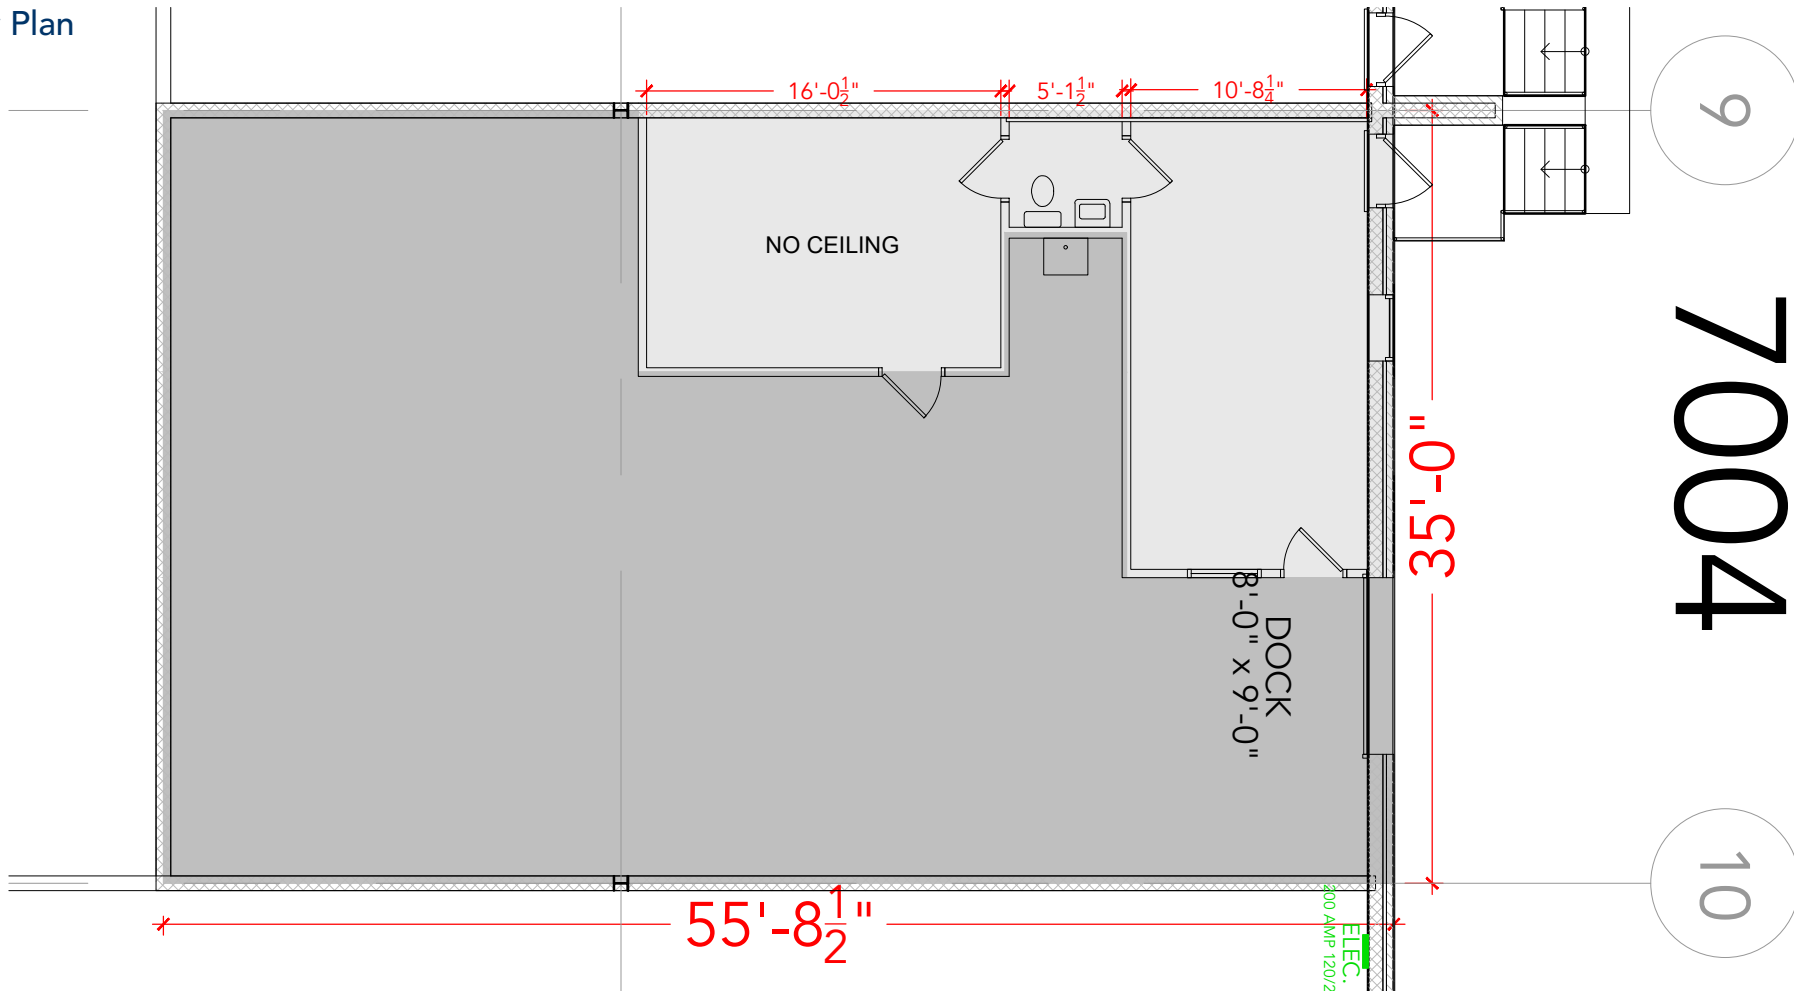

Floor Plan