


**TOTAL SF AVAILABLE - 7,150 SF**


OFFICE - 1,933 SF

WAREHOUSE - 5,218 SF

[Click to access 3D model](#)

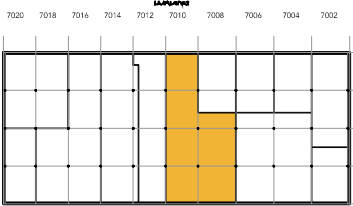

Key Plan

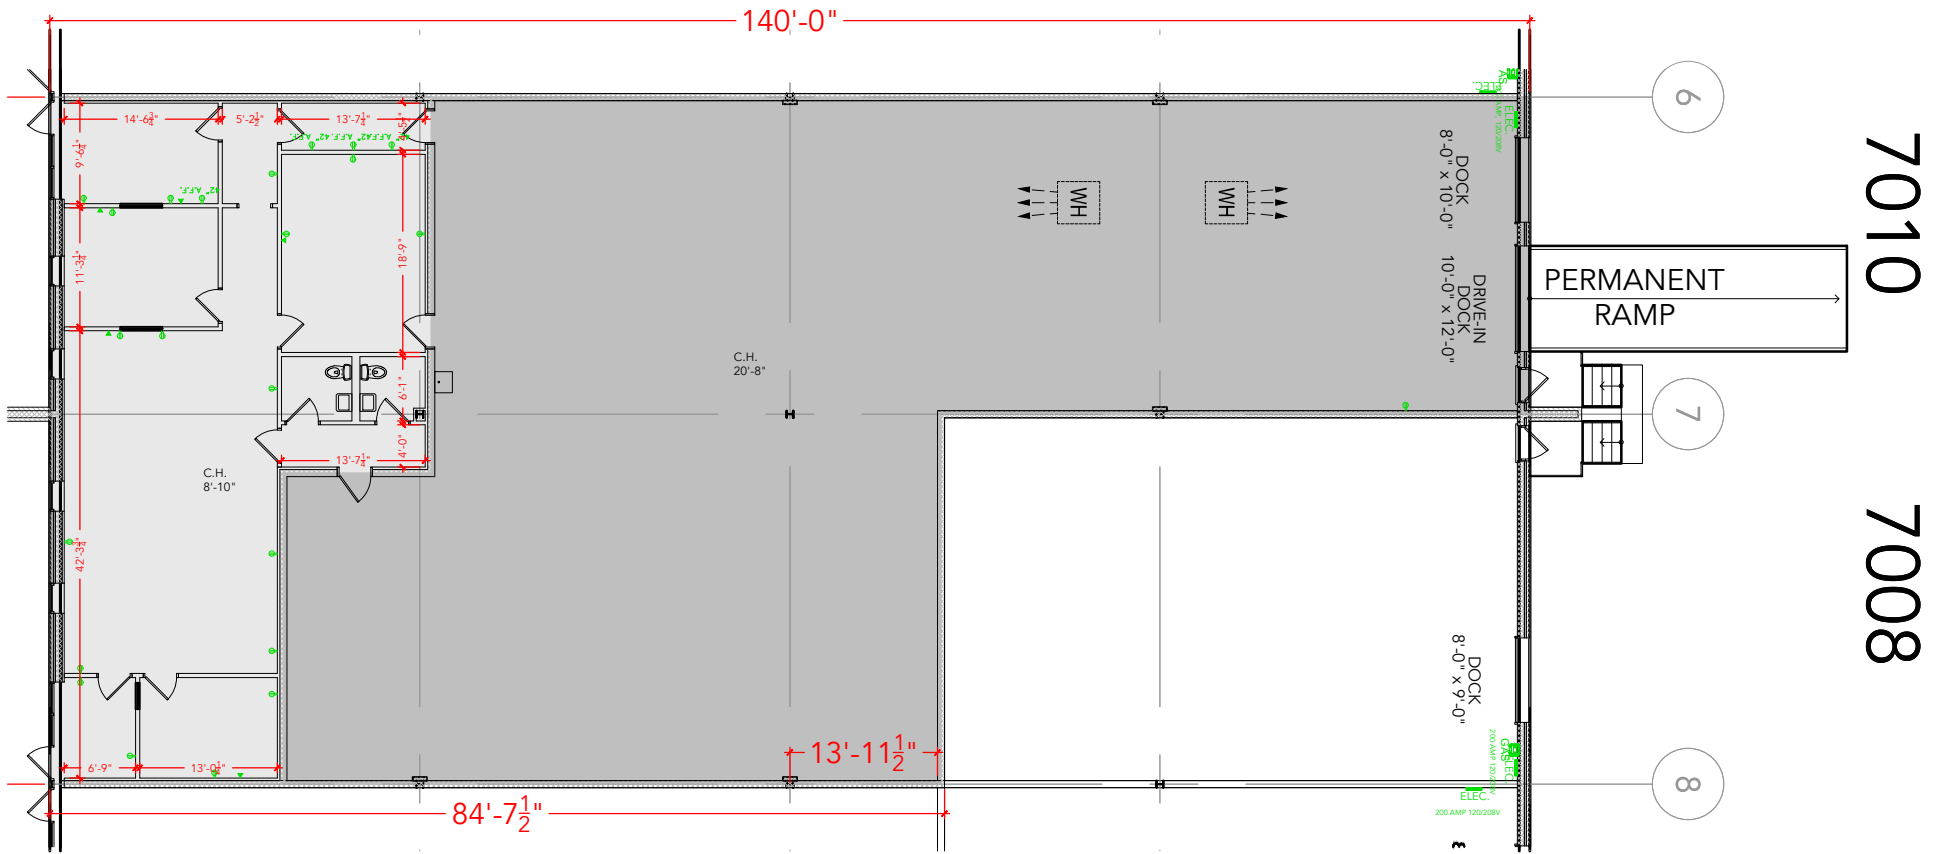

Floor Plan