


TOTAL SF AVAILABLE - 6,300 SF

OFFICE - 1,486 SF

WAREHOUSE SF - 4,814 SF

[Click to access 3D model](#)

Key Plan

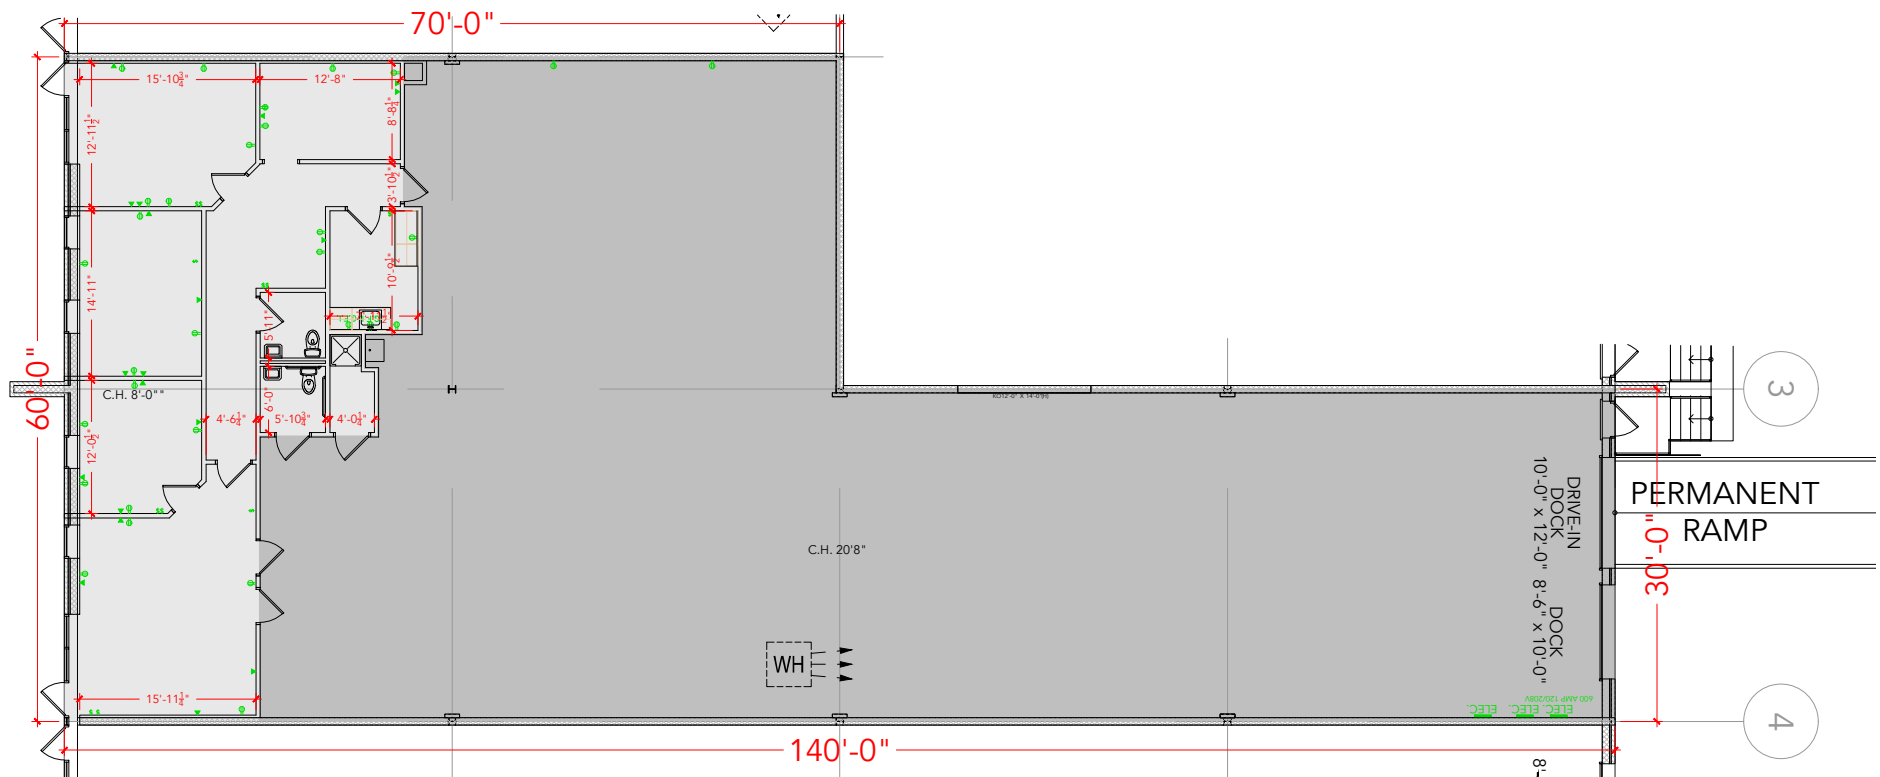

Floor Plan