


TOTAL SF AVAILABLE - 11,250 SF

OFFICE - 0,000 SF


WAREHOUSE - 11,250 SF

[Click to access 3D model](#)

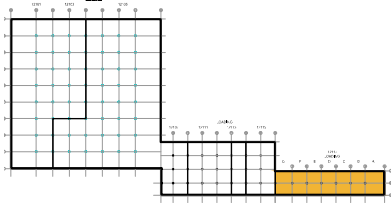

Key Plan

LOADING

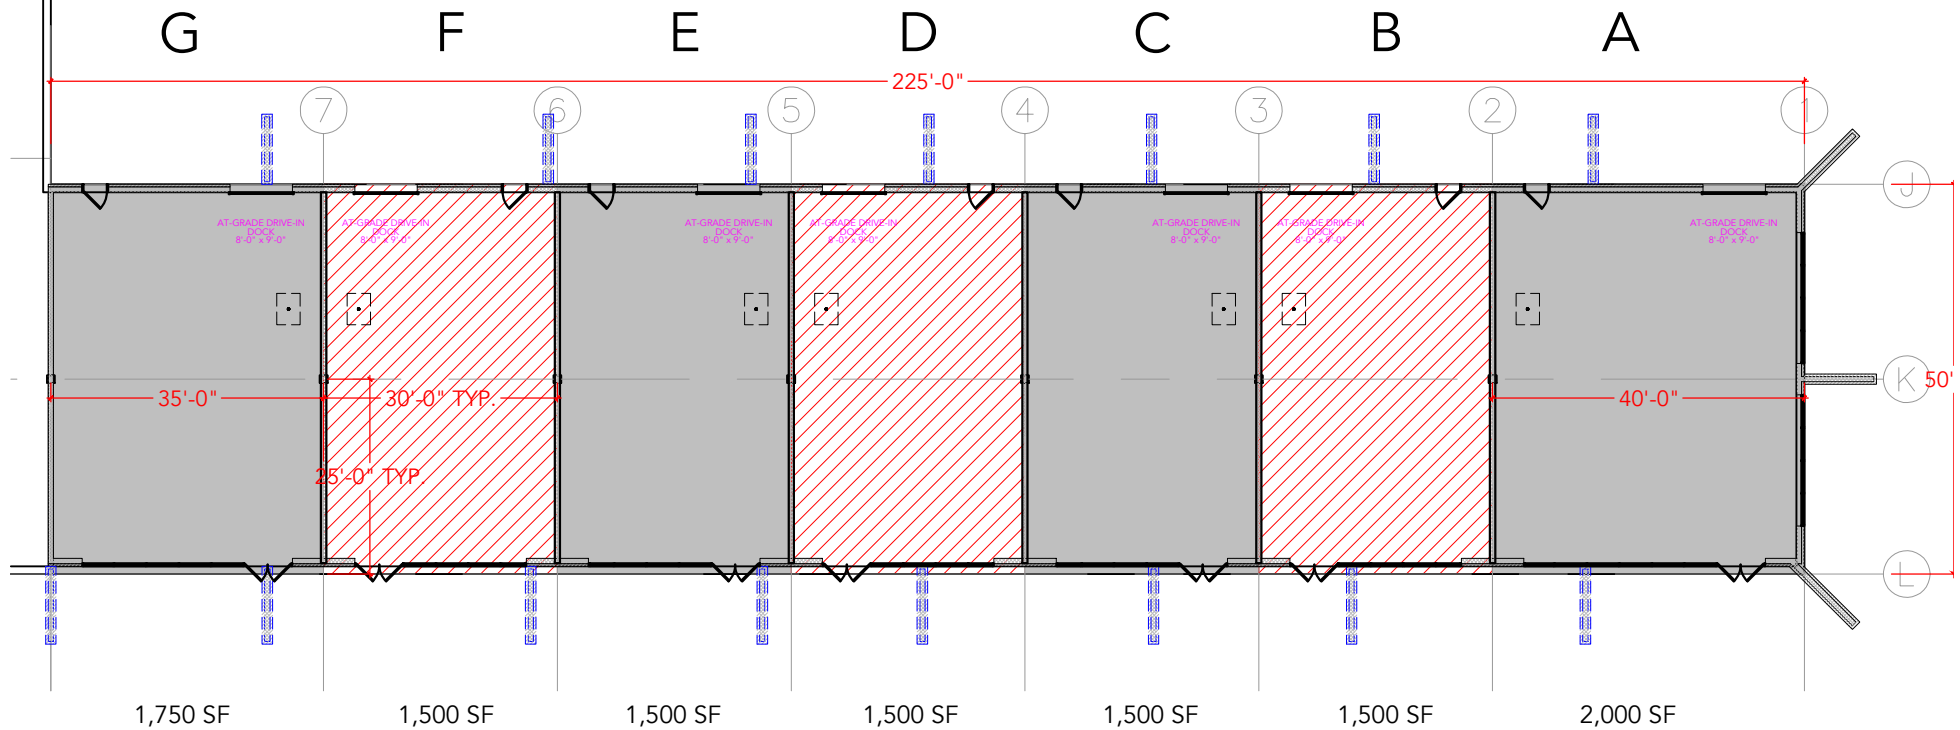

Floor Plan