



TOTAL SF AVAILABLE - 945 RSF(12%)

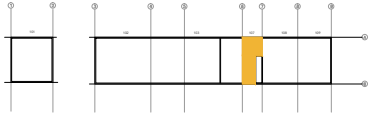

[Click to access 3D model](#)

Key Plan

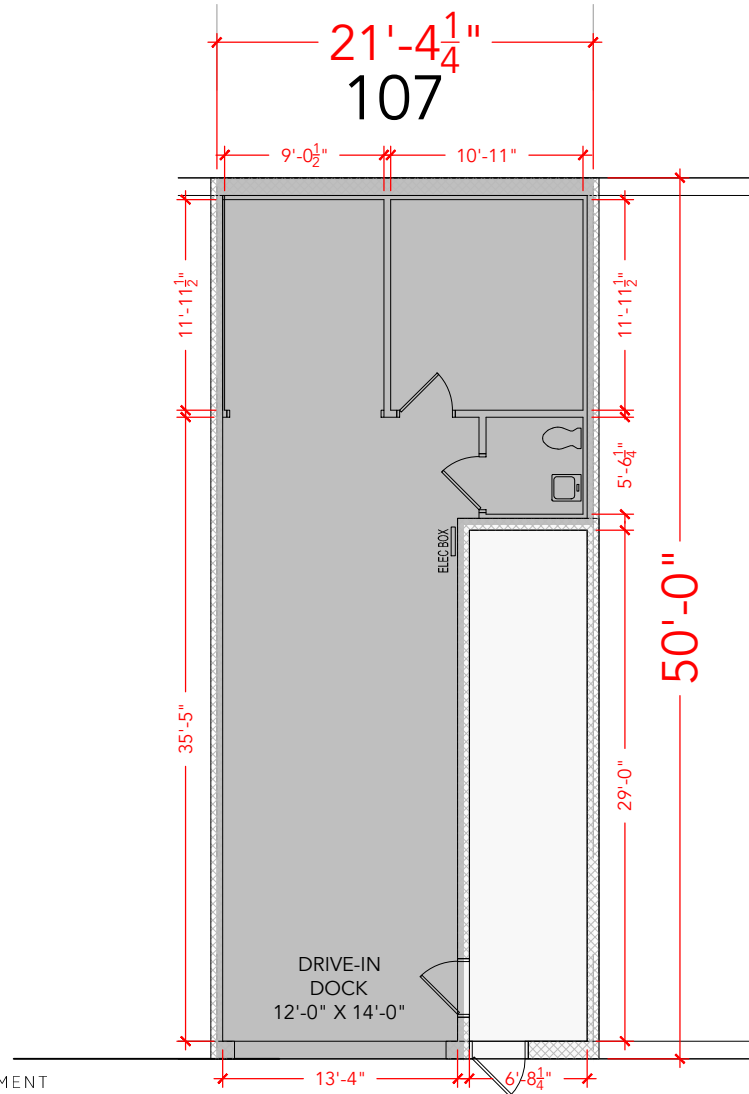

MEC. SPR.

Floor Plan