



TOTAL SF AVAILABLE - 1,800 SF

OFFICE - 304 SF
WAREHOUSE SF - 1,496 SF

[Click to access 3D model](#)

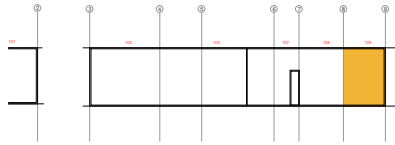

Key Plan

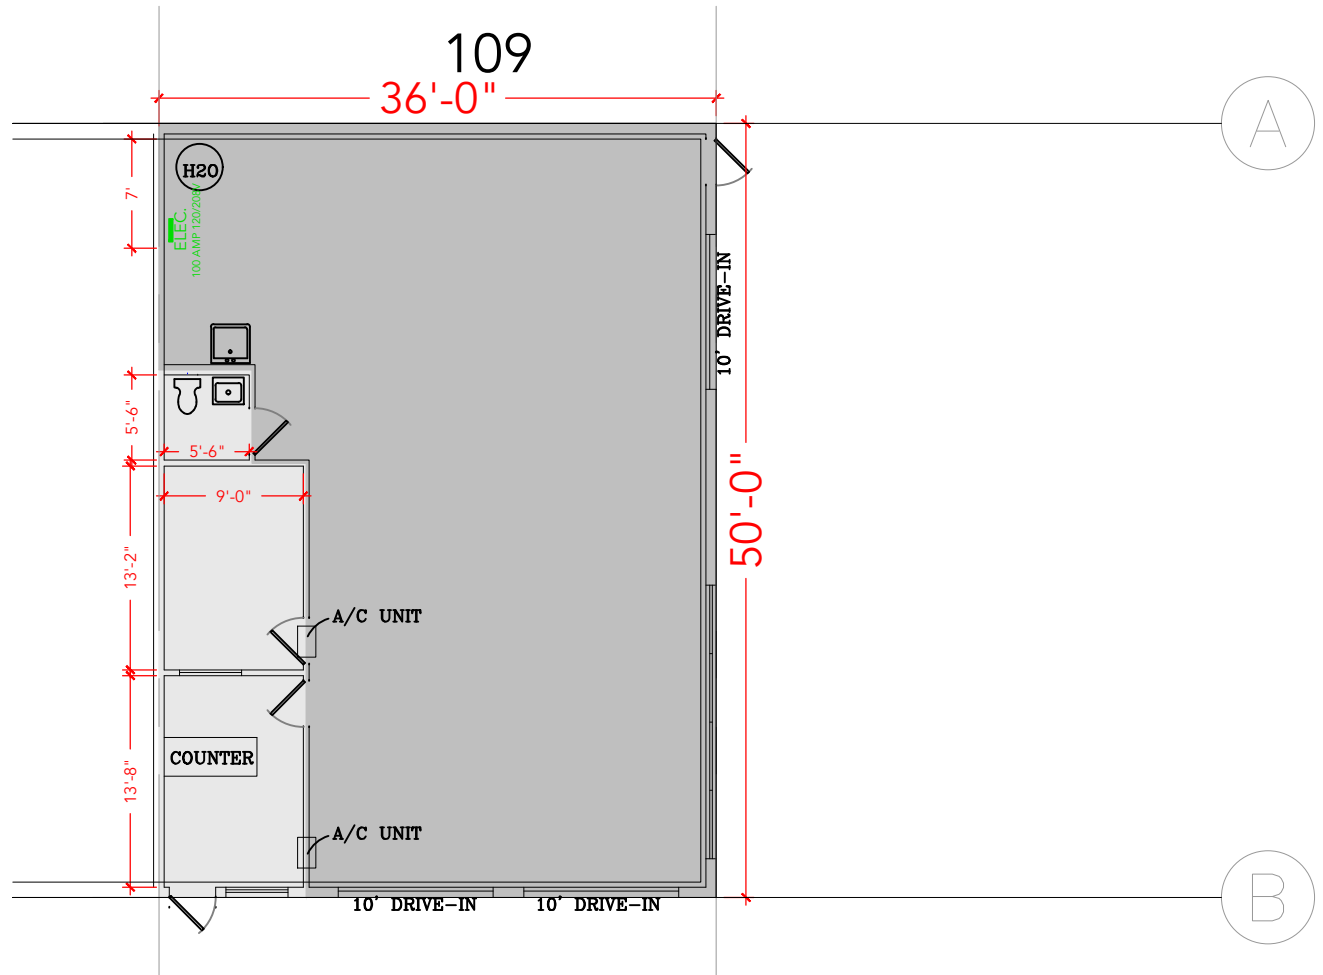

Floor Plan