


TOTAL SF AVAILABLE - 7,050 SF


OFFICE - 0,000 SF

WAREHOUSE SF - 7,050 SF

[Click to access 3D model](#)

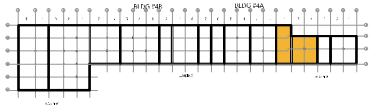

Key Plan

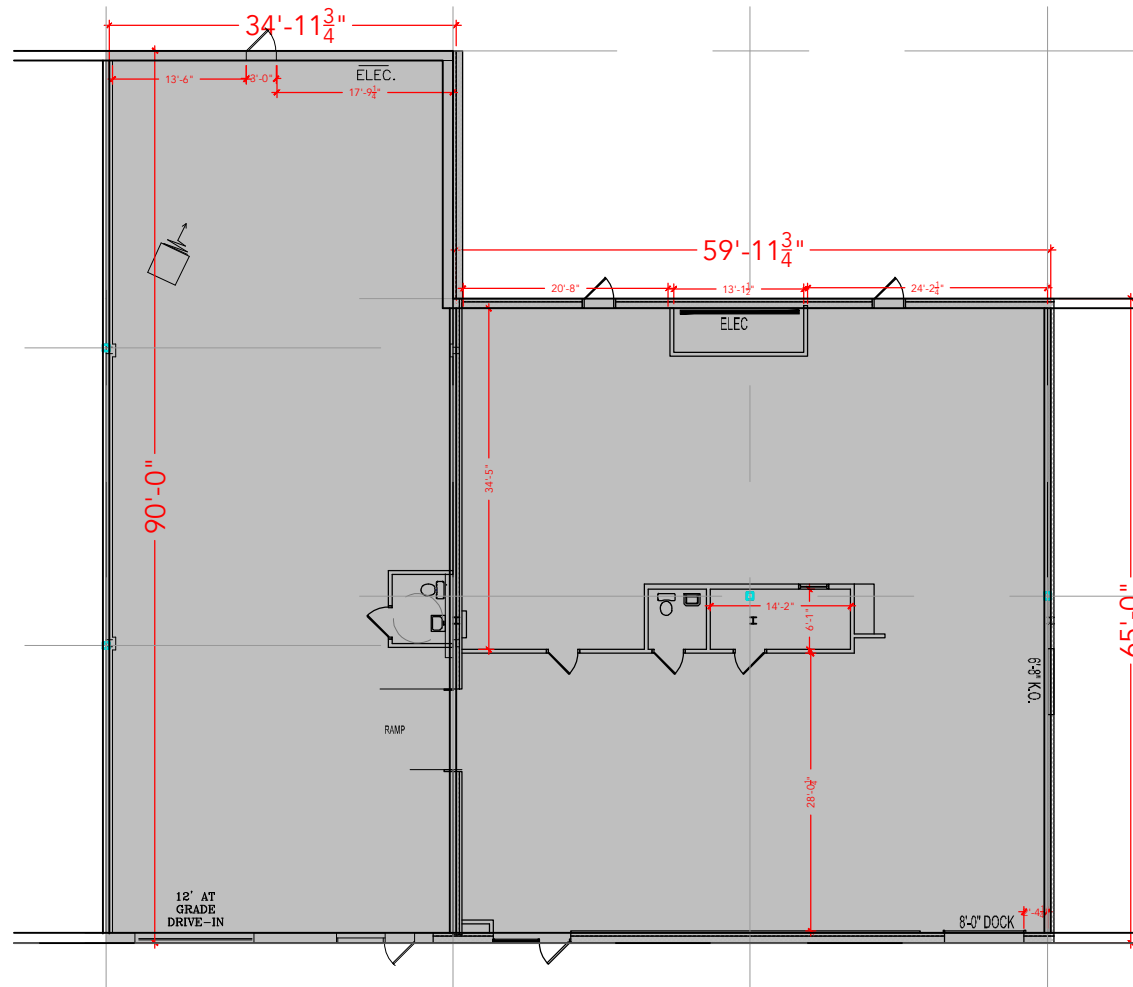

Floor Plan