


TOTAL SF AVAILABLE - 1,950 SF


OFFICE - 1,461 SF

WAREHOUSE SF - 489 SF

[Click to access 3D model](#)

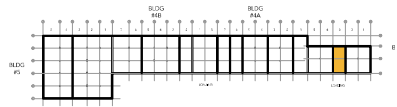

Key Plan

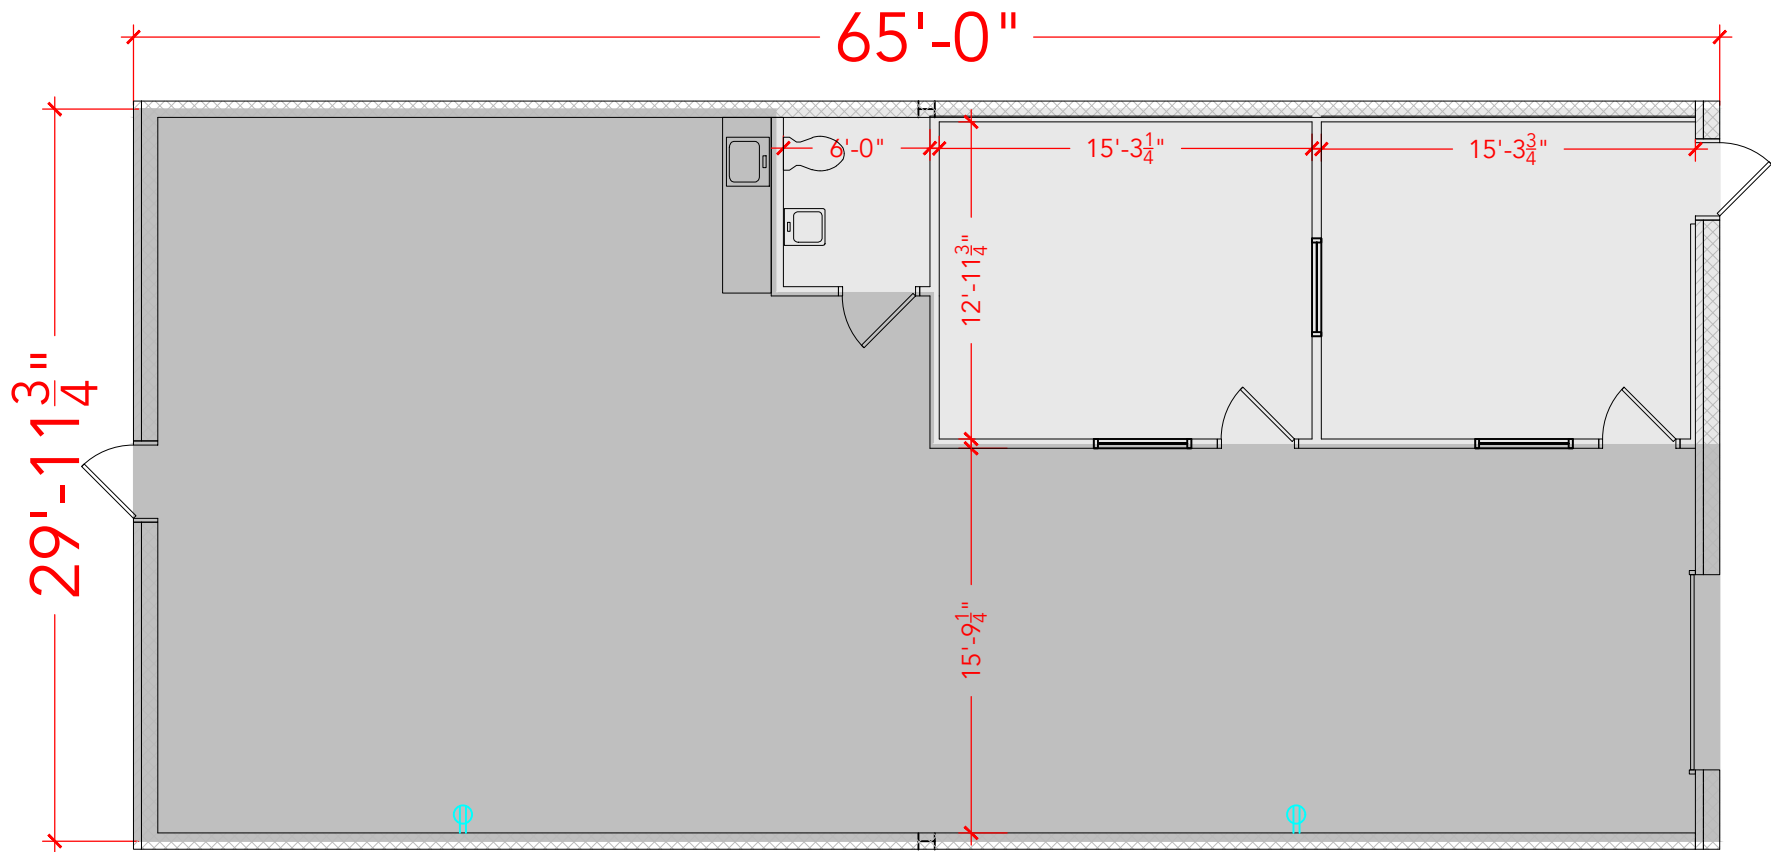

## Floor Plan