


TOTAL SF AVAILABLE - 1,950 SF


OFFICE - 1,461 SF

WAREHOUSE SF - 489 SF

[Click to access CADD file](#)

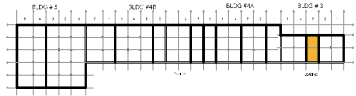

Key Plan

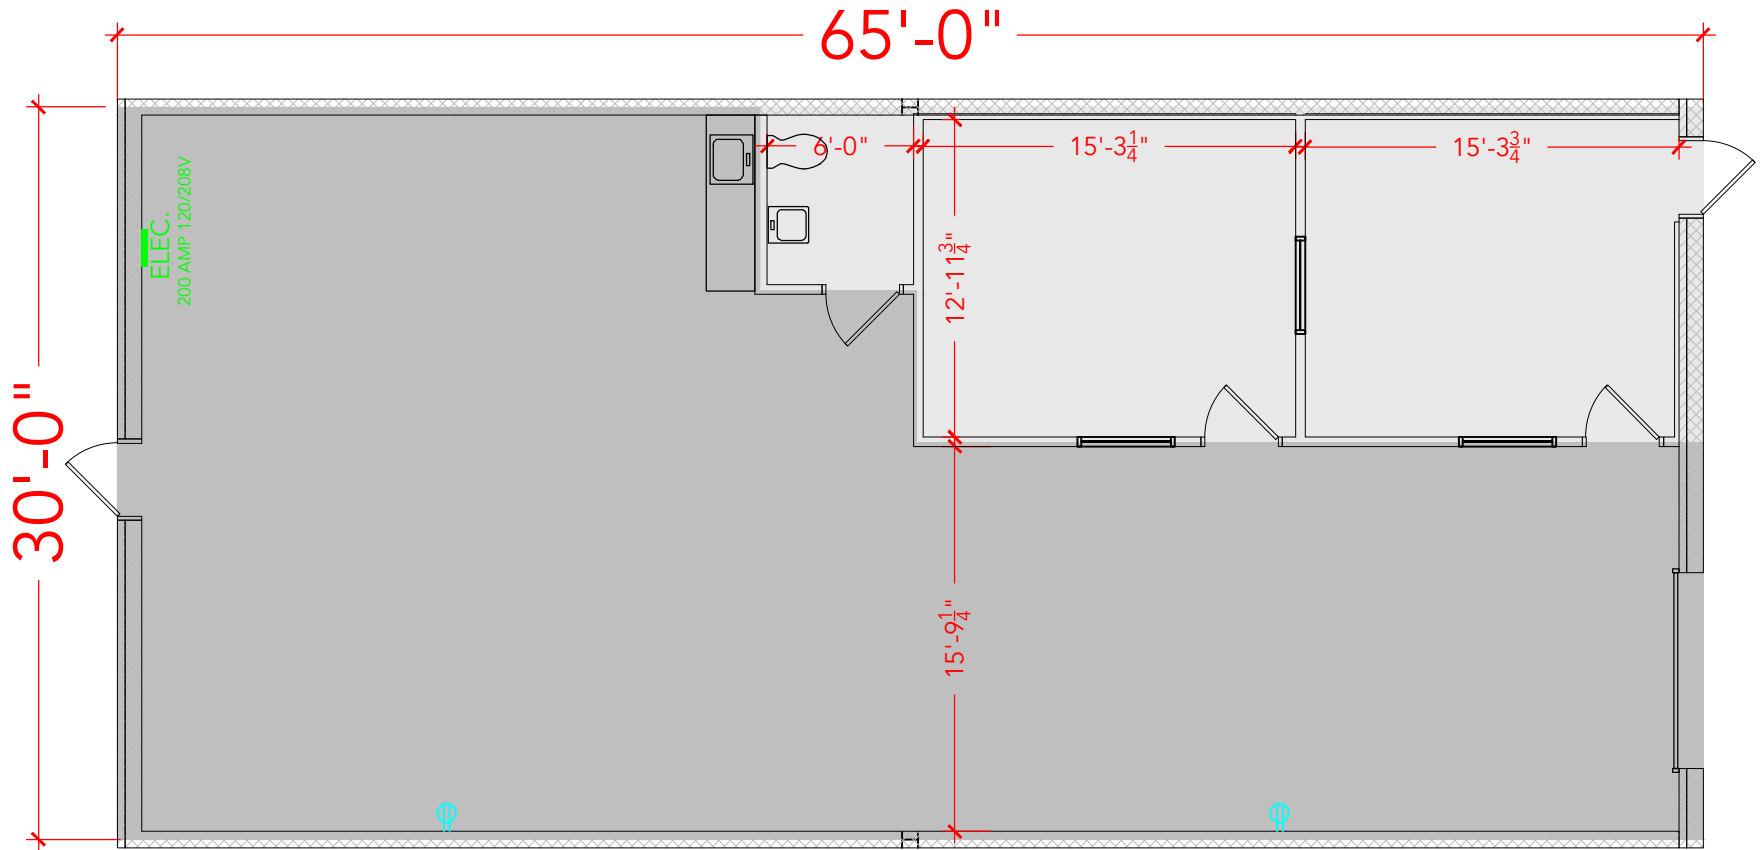

Floor Plan