
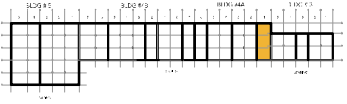


TOTAL SF AVAILABLE -3,150 SF[Click to access CADD file](#)

Key Plan

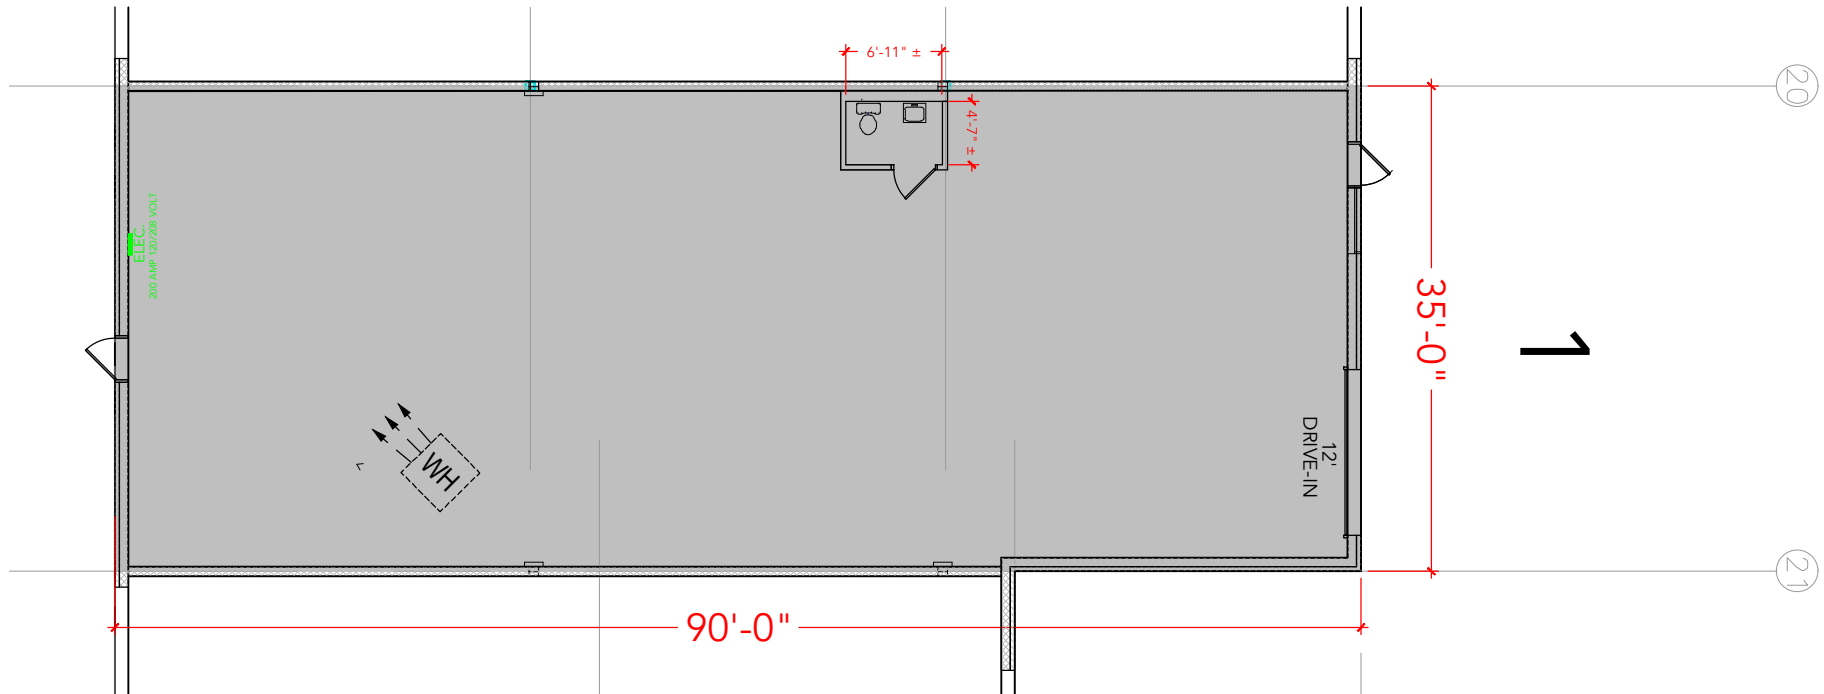

Floor Plan