



TOTAL SF AVAILABLE - 2,700 SF

OFFICE - 190 SF
WAREHOUSE SF - 2,510 SF

[Click to access 3D model](#)

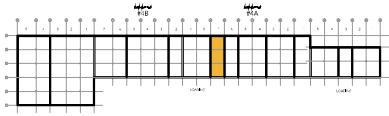

Key Plan

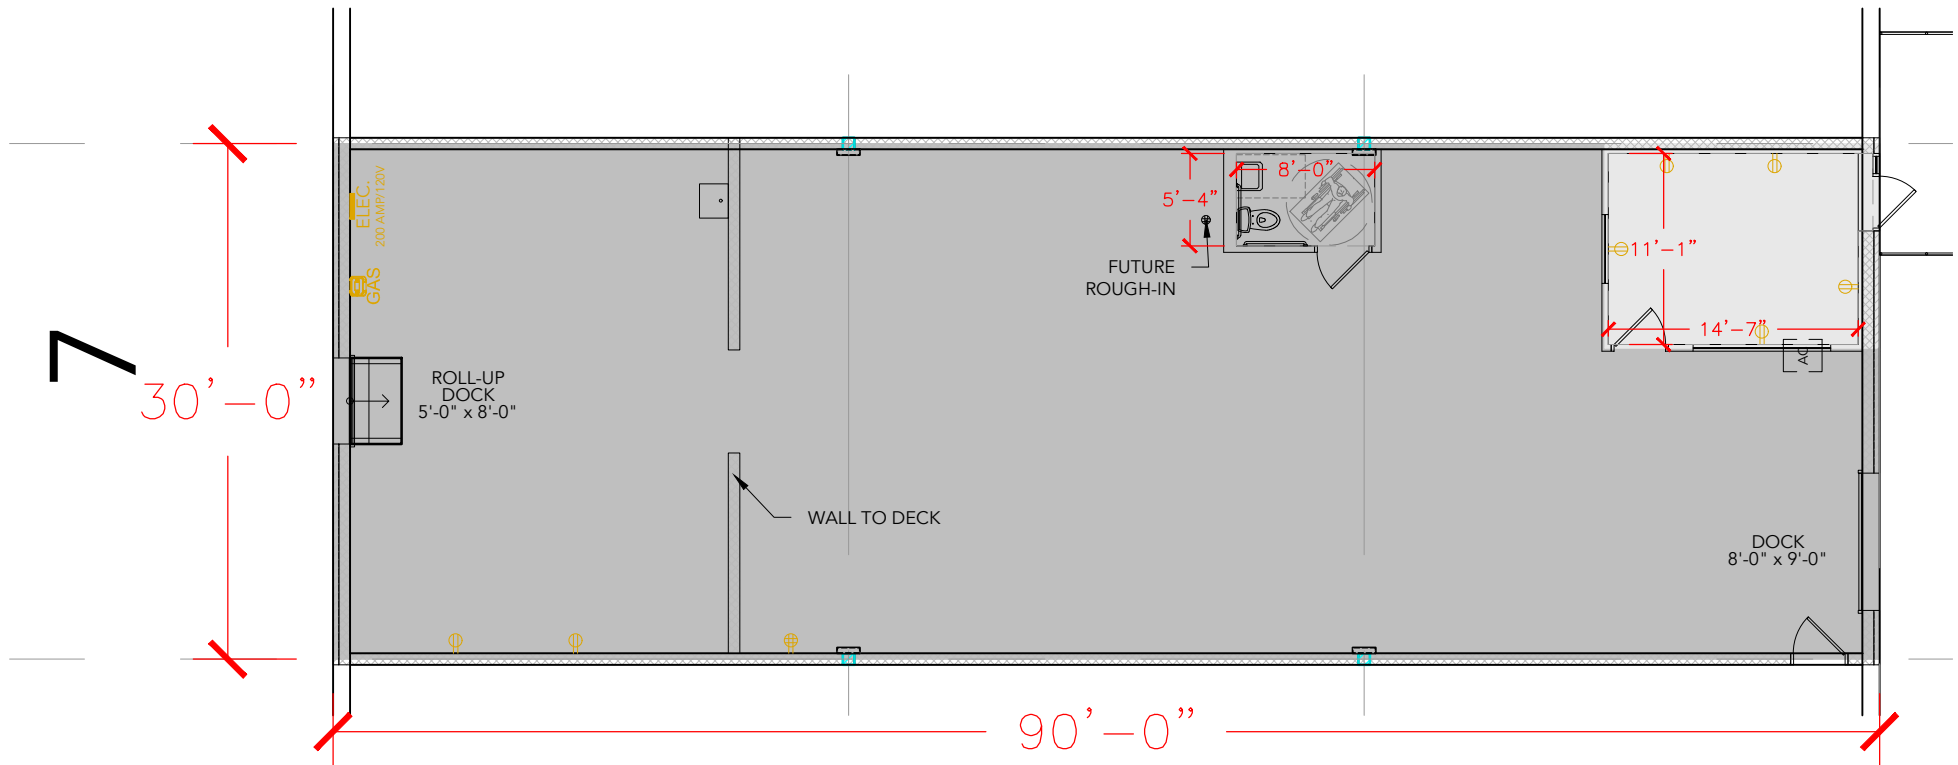

Floor Plan