


TOTAL SF AVAILABLE - 8,100 SF


OFFICE - 1,105 SF

WAREHOUSE - 6,995 SF

[Click to access 3D model](#)

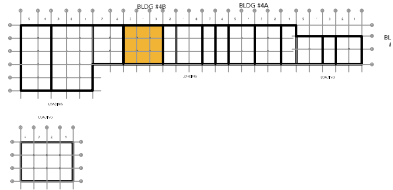

Key Plan

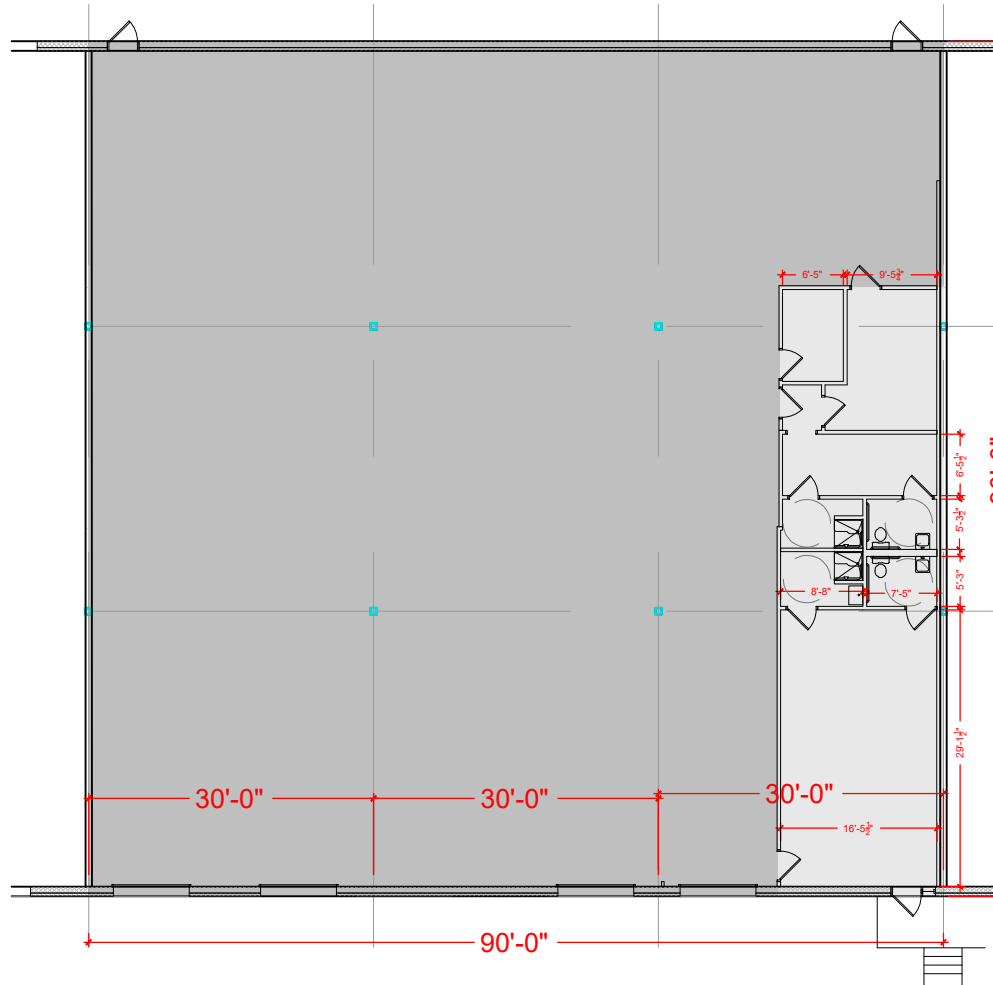

Floor Plan