


TOTAL SF AVAILABLE - 28,650 SF

OFFICE - 3,216 SF

WAREHOUSE - 25,434 SF

BASE AND SUITE FILE IS
CONVERTED TO REVIT
(06.06.22 TD)

Key Plan

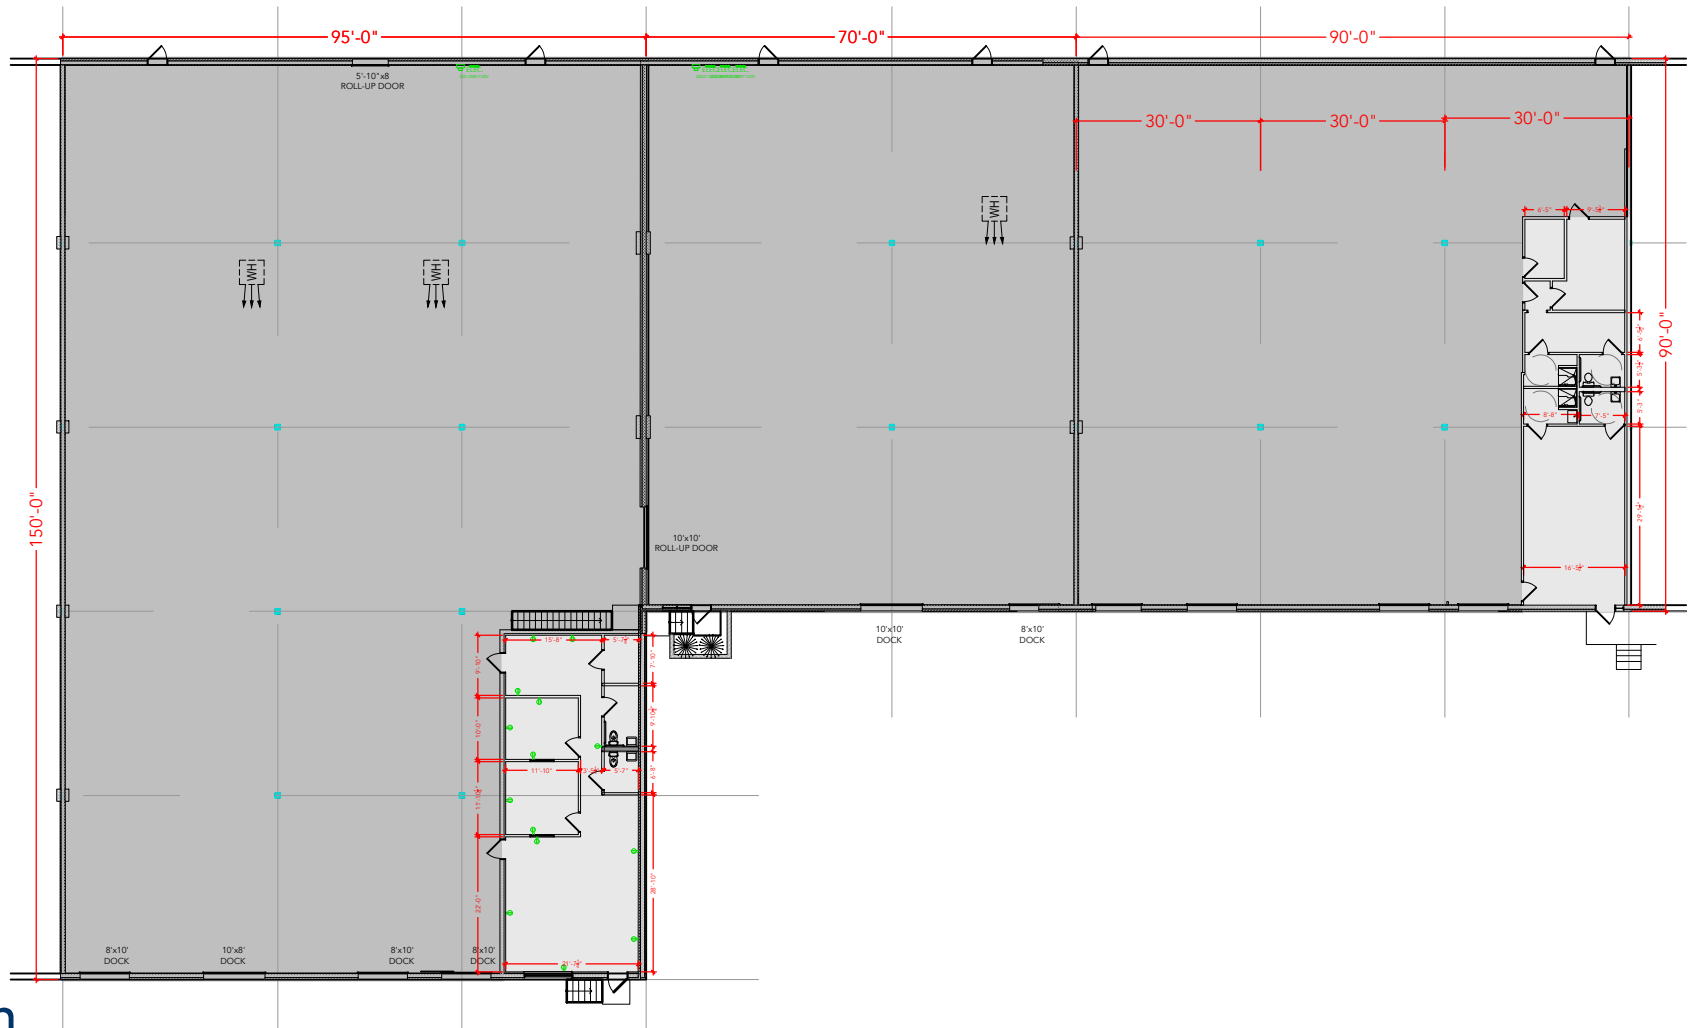

Floor Plan