


TOTAL SF AVAILABLE - 20,550 SF


OFFICE - 2,111 SF

WAREHOUSE - 18,439 SF

[Click to access 3D model](#)

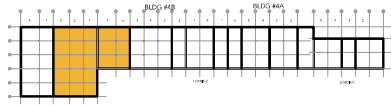

Key Plan

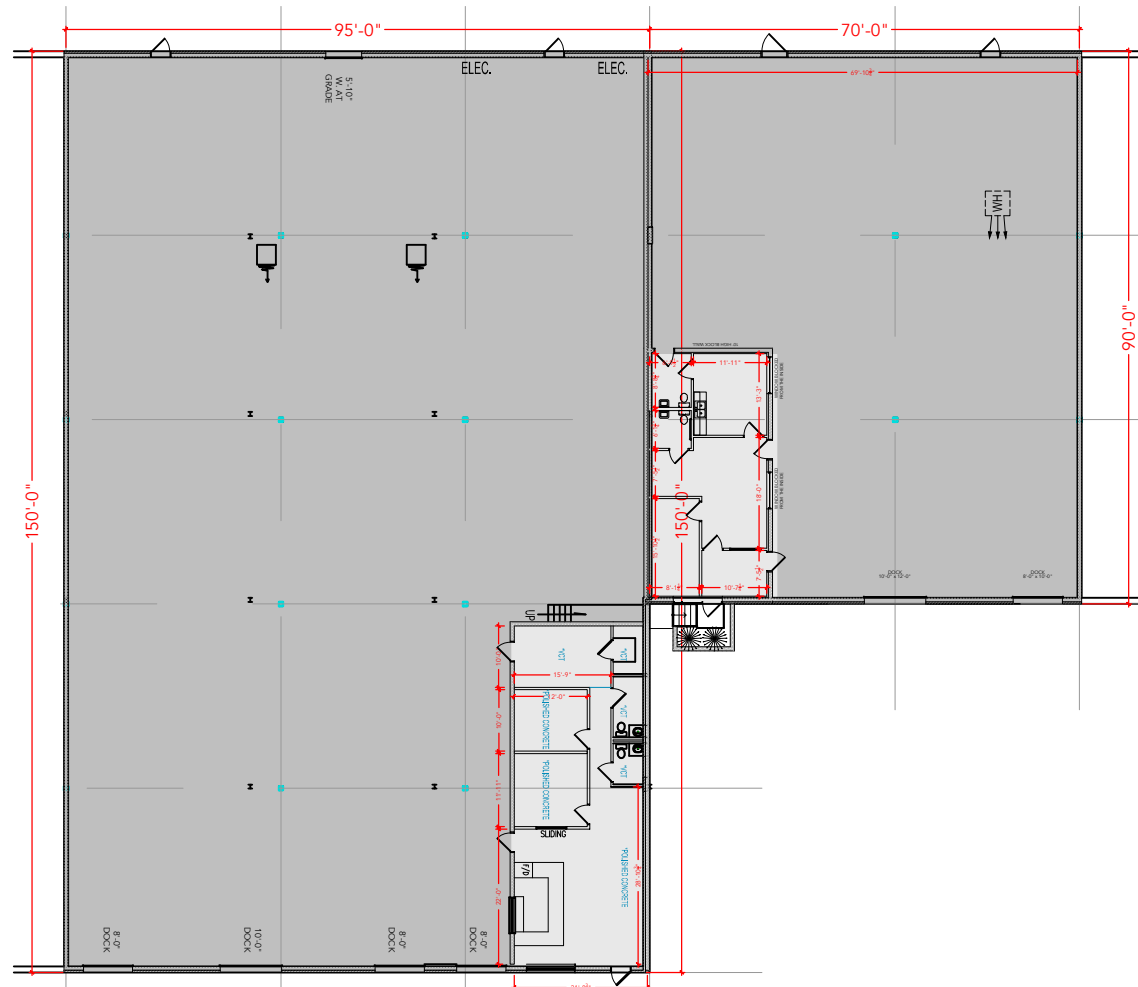

Floor Plan