
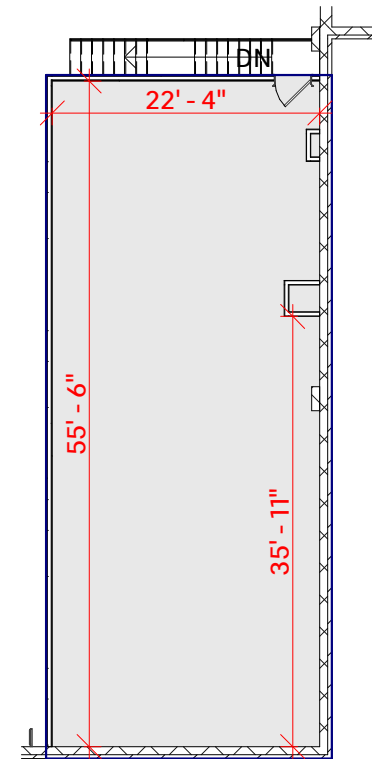


TOTAL SF AVAILABLE -20,550 SF

OFFICE -1,331 SF

WAREHOUSE -19,219 SF

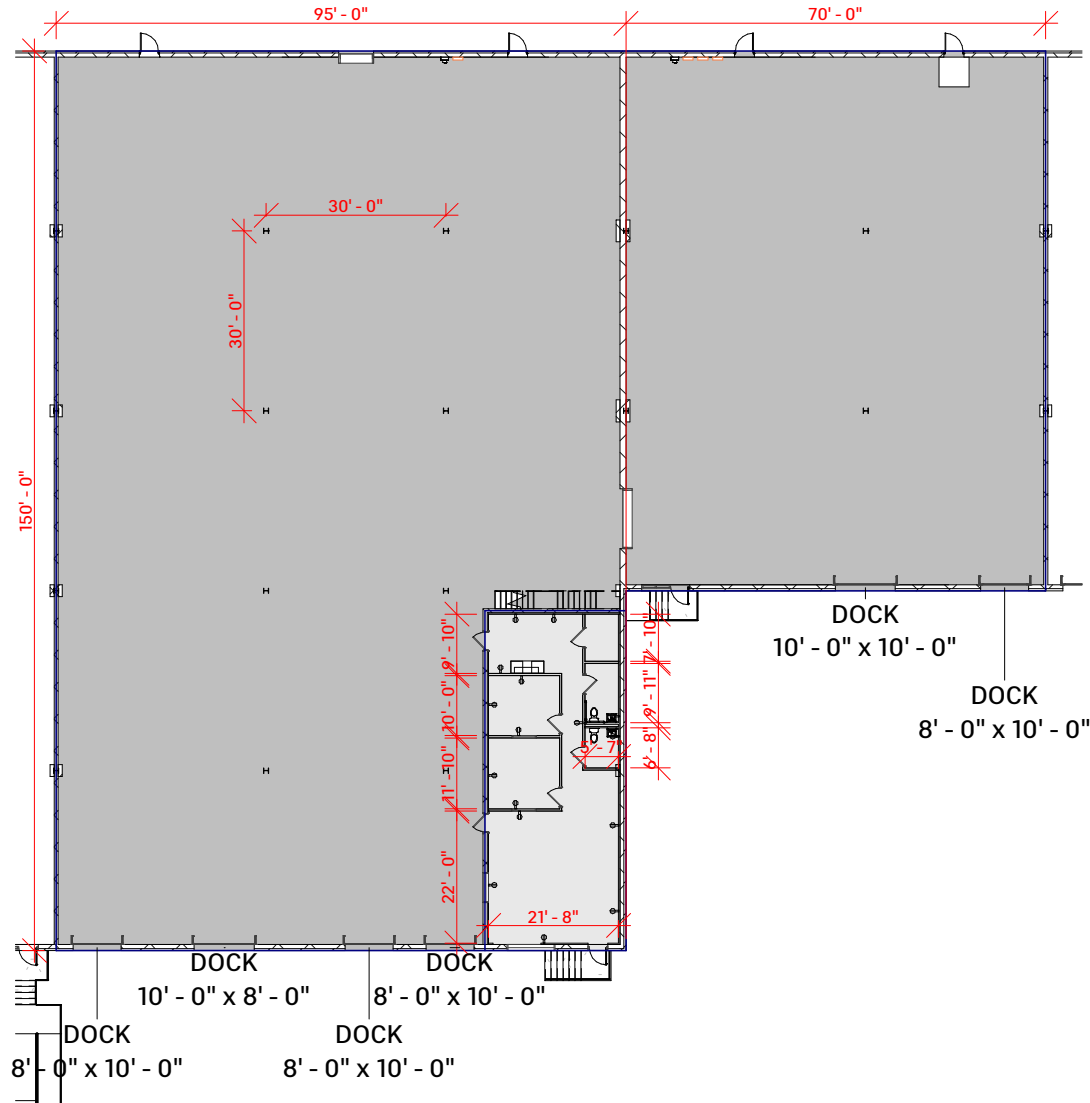

MEZZ



TOTAL SF AVAILABLE -20,550 SF  
OFFICE -1,331 SF  
WAREHOUSE -19,219 SF

