


TOTAL SF AVAILABLE - 20,000 SF

OFFICE - 6,453 SF


WAREHOUSE SF - 13,547 SF

*3,377 MEZZ. SQFT NOT INCLUDED IN TOTAL SQFT

[Click to access 3D model](#)

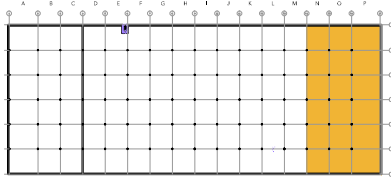

Key Plan

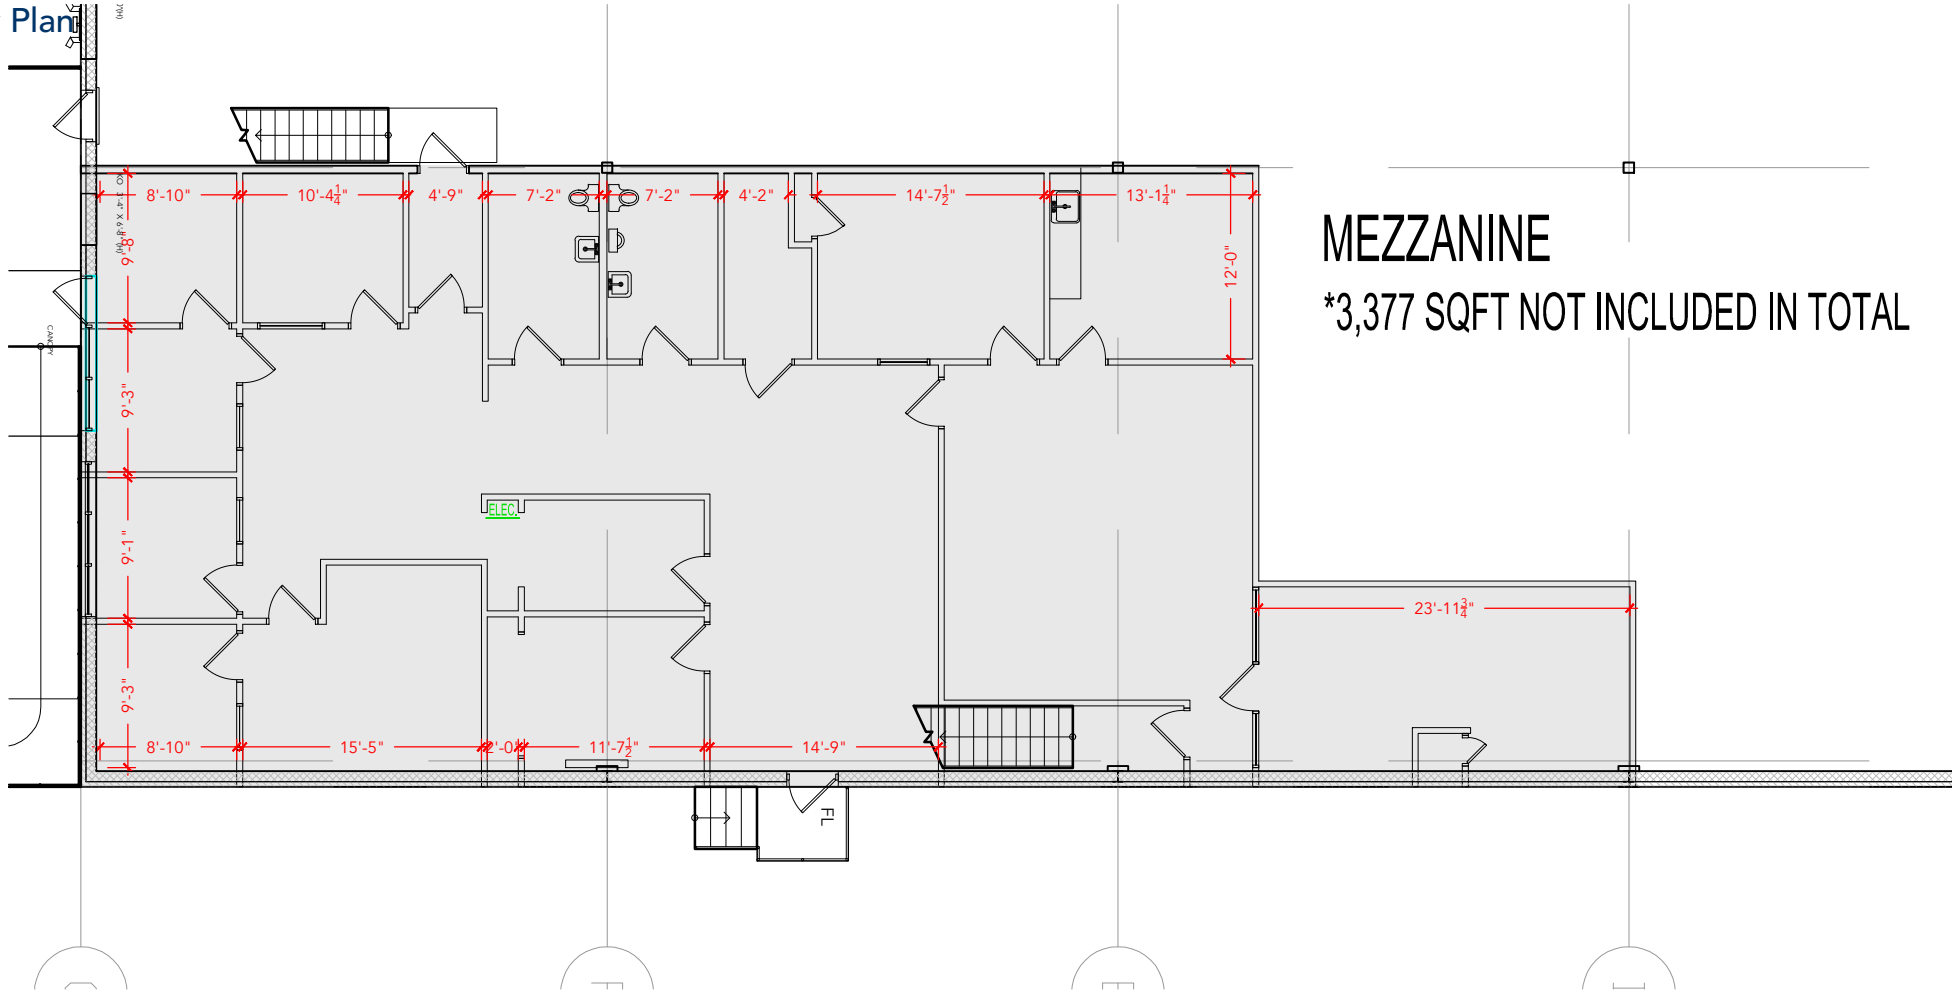

Floor Plan