


TOTAL SF AVAILABLE - 5,400 SF


OFFICE - 694 SF

WAREHOUSE - 4,706 SF

[Click to access 3D model](#)

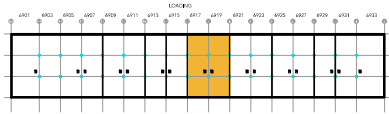

Key Plan

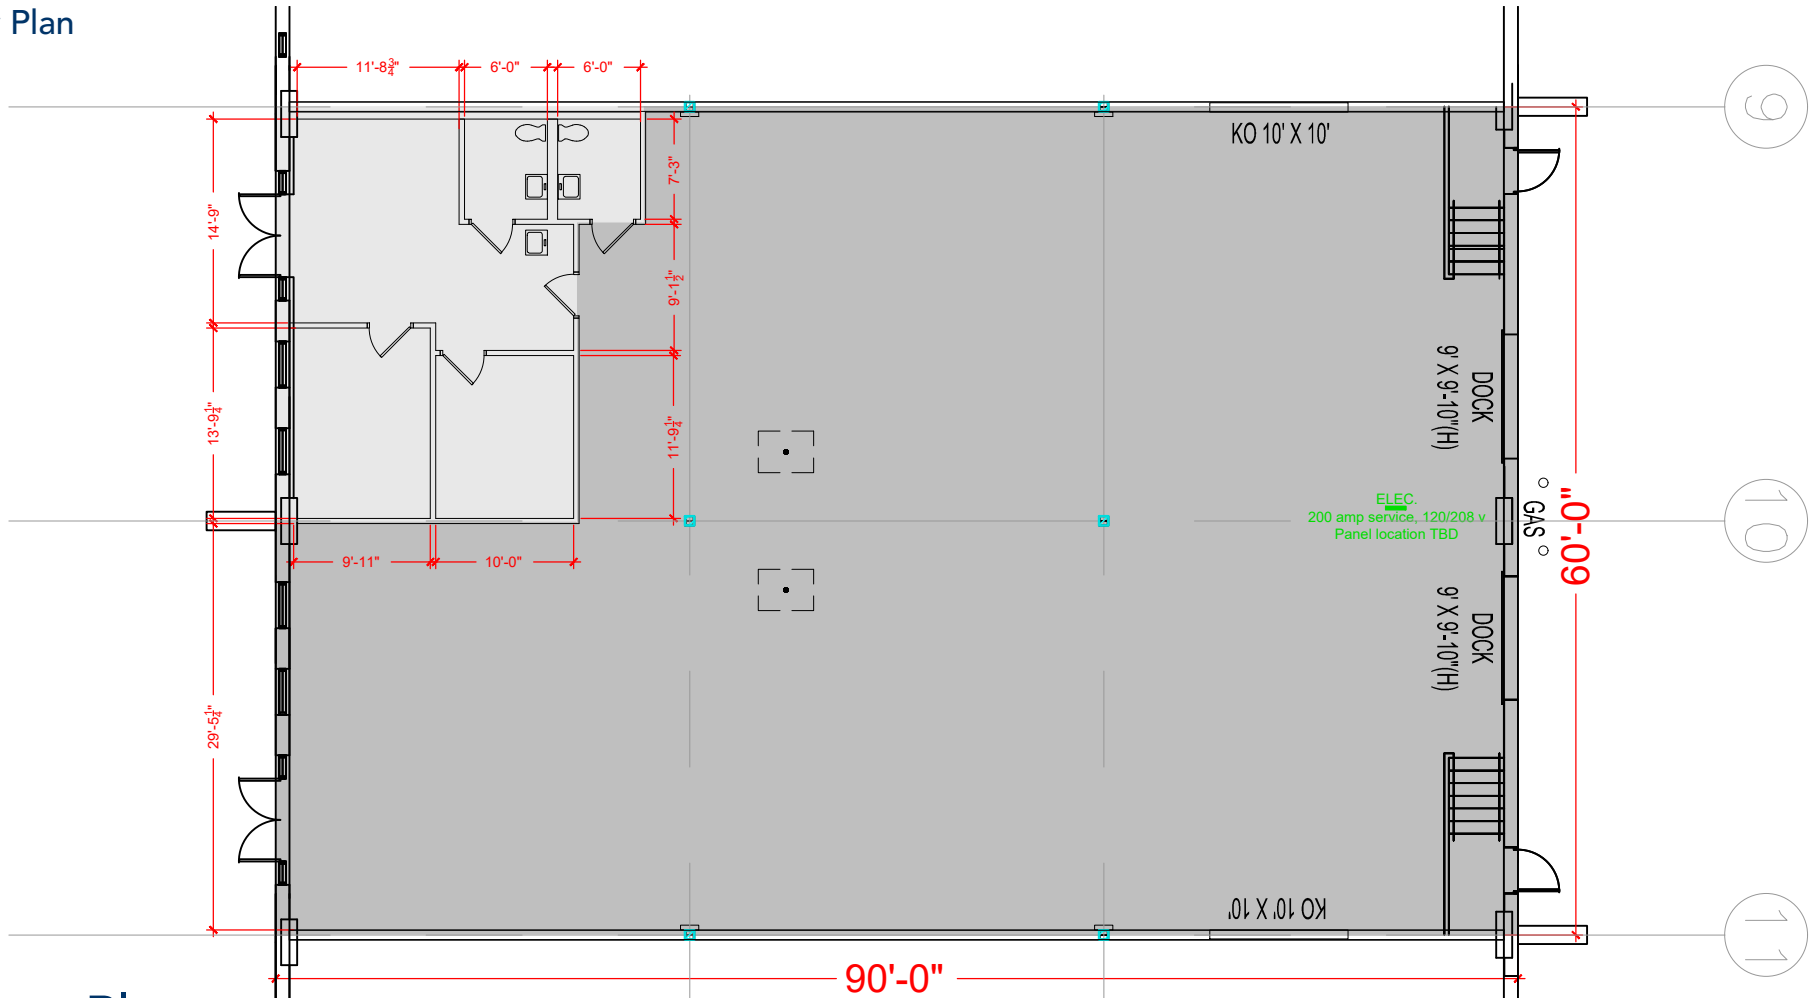

Floor Plan