



TOTAL SF AVAILABLE - 5,400 SF

OFFICE - 2,223 SF
WAREHOUSE - 3,177 SF

[Click to access CADD file](#)

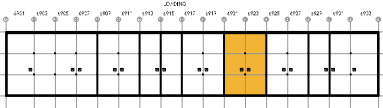

Key Plan

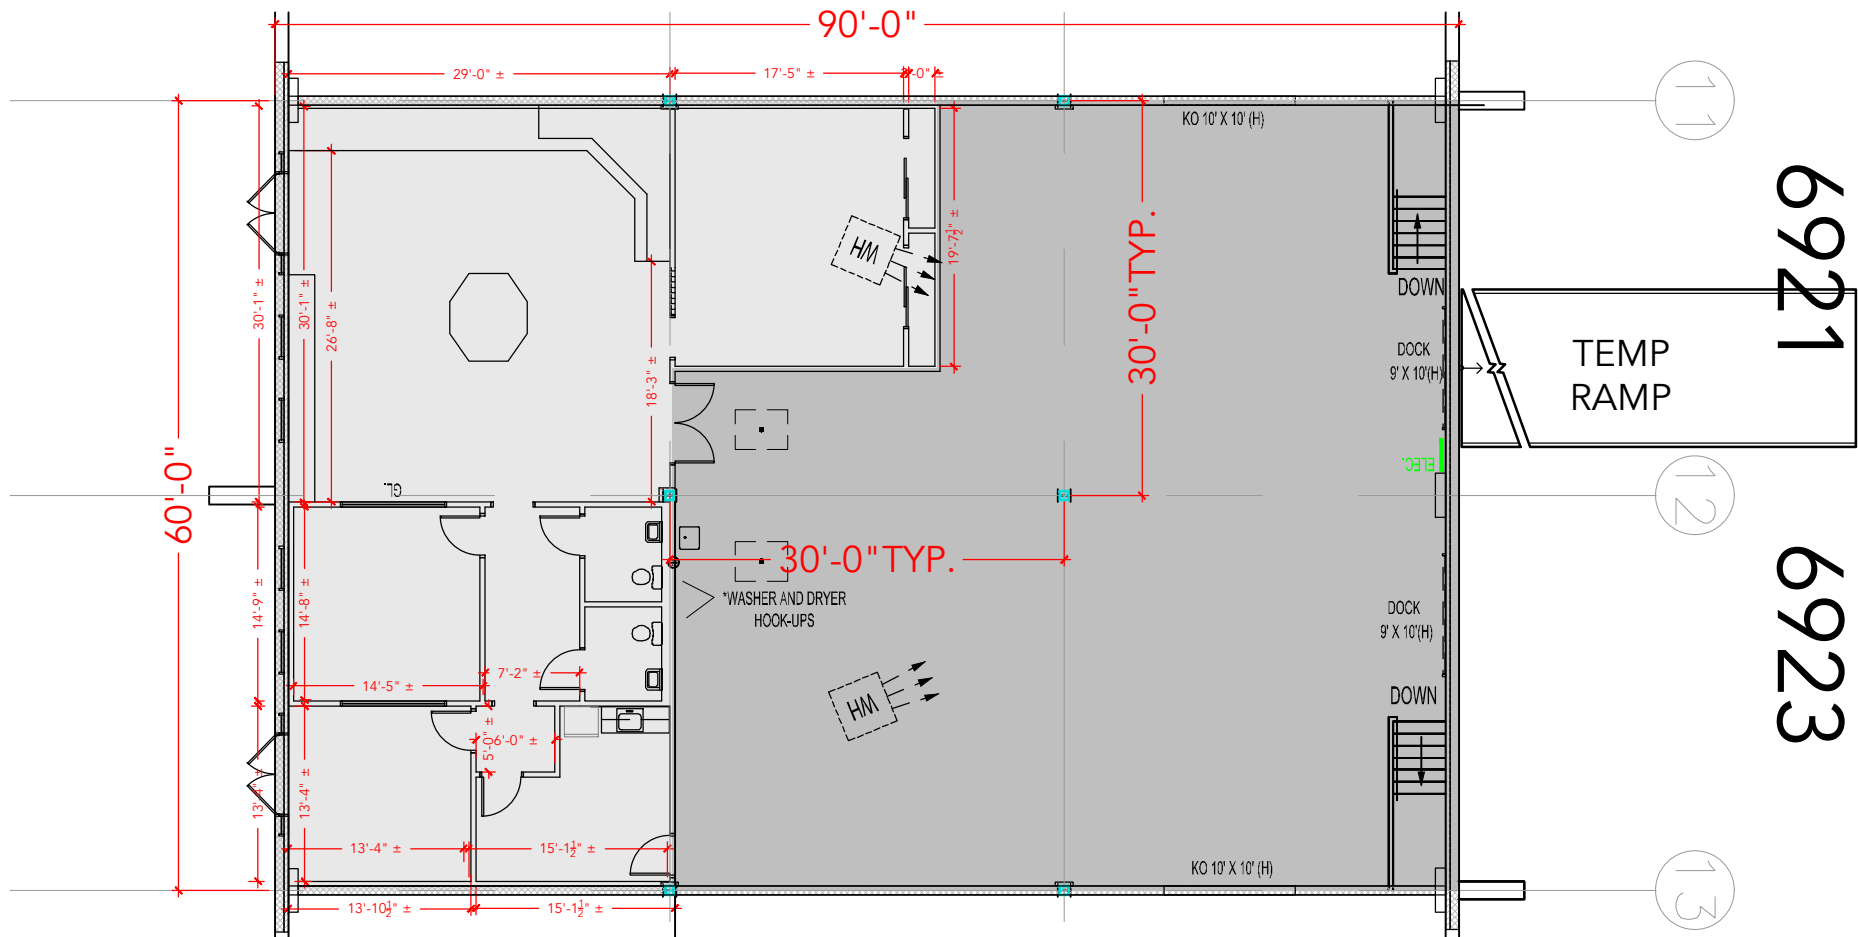

Floor Plan