


TOTAL SF AVAILABLE - 5,400 SF


OFFICE - 2,218 SF

WAREHOUSE - 3,182 SF

[Click to access CADD file](#)

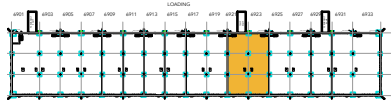

Key Plan

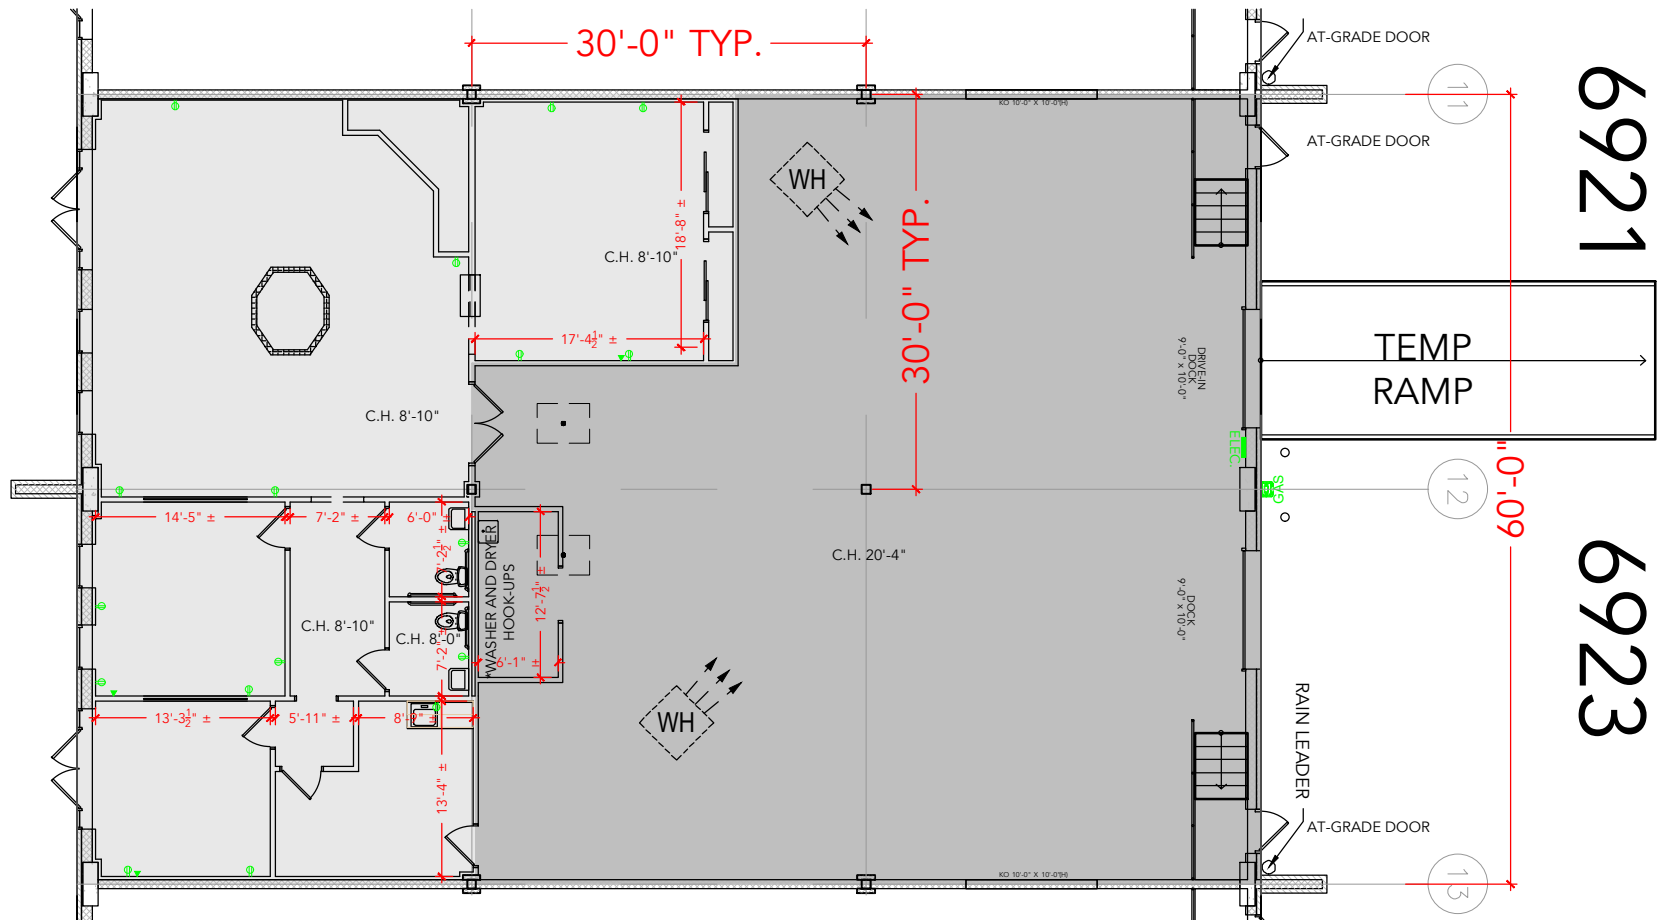

Floor Plan