


**TOTAL SF AVAILABLE - 6,275 SF**


OFFICE - 1,092 SF

WAREHOUSE - 5,183 SF

[Click to access 3D model](#)

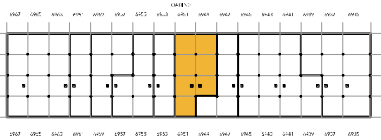

Key Plan

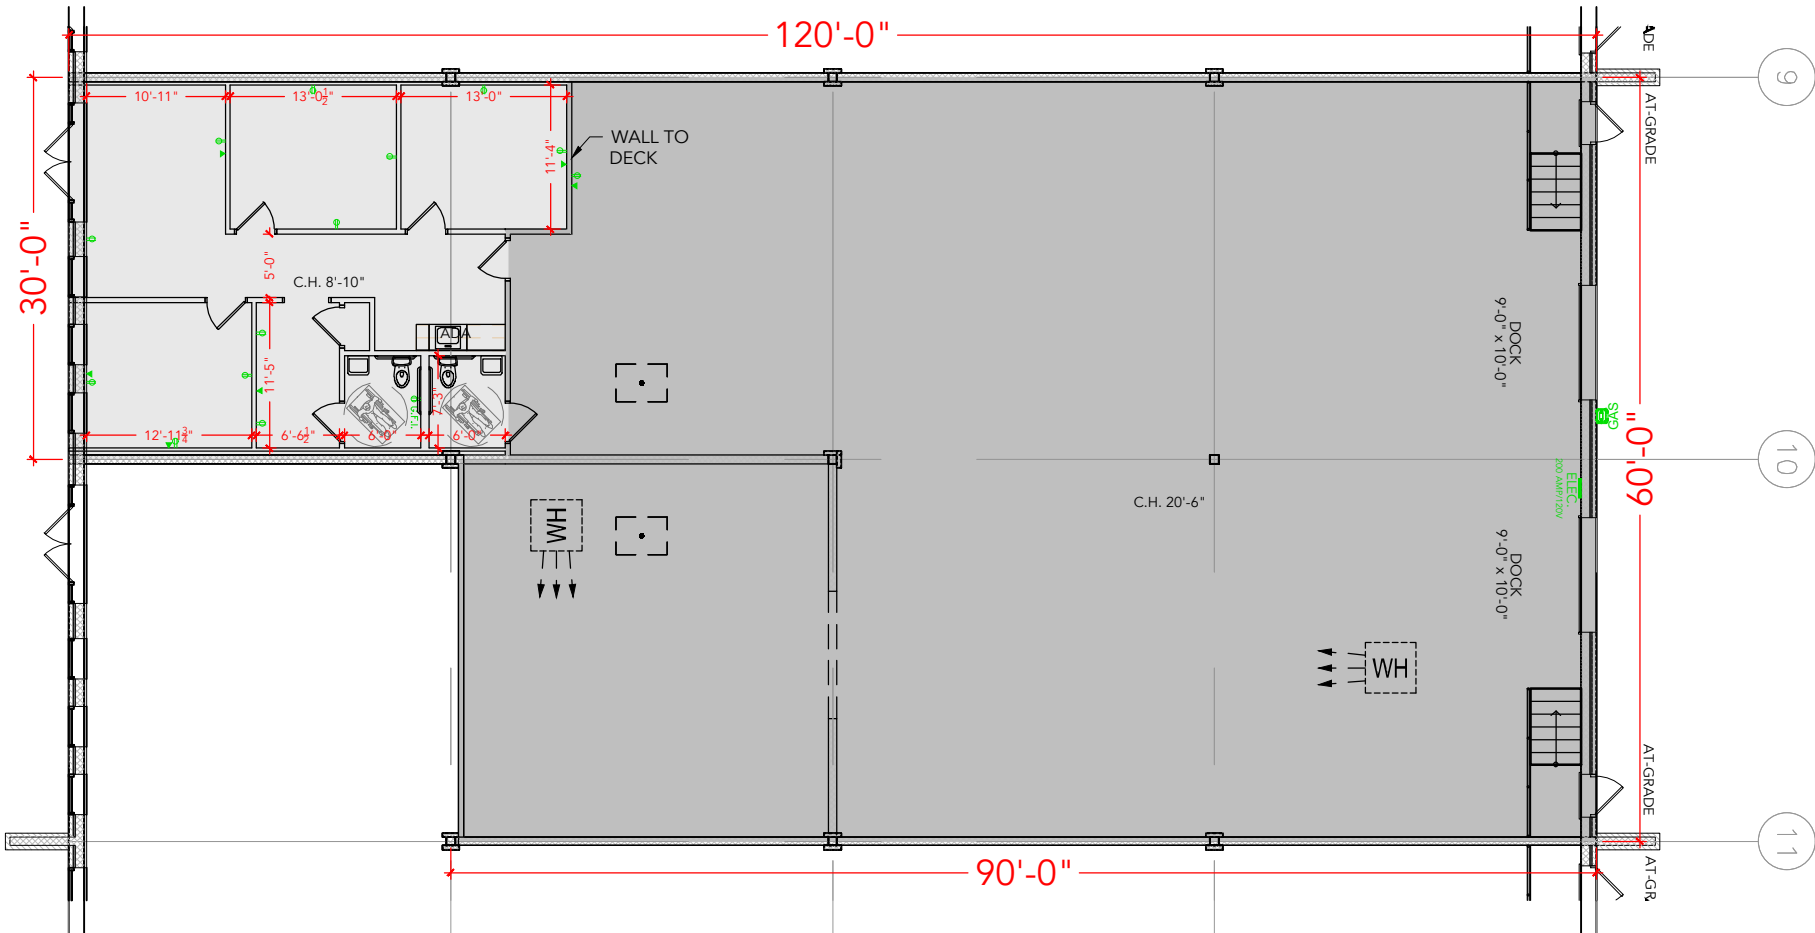

6951

6949

6

Floor Plan